


Town of Cheshire, Connecticut
 Figure 5-2
 Sewer Recommendation
 for Unsewered Properties

March, 2008

METCALF & EDDY | AECOM

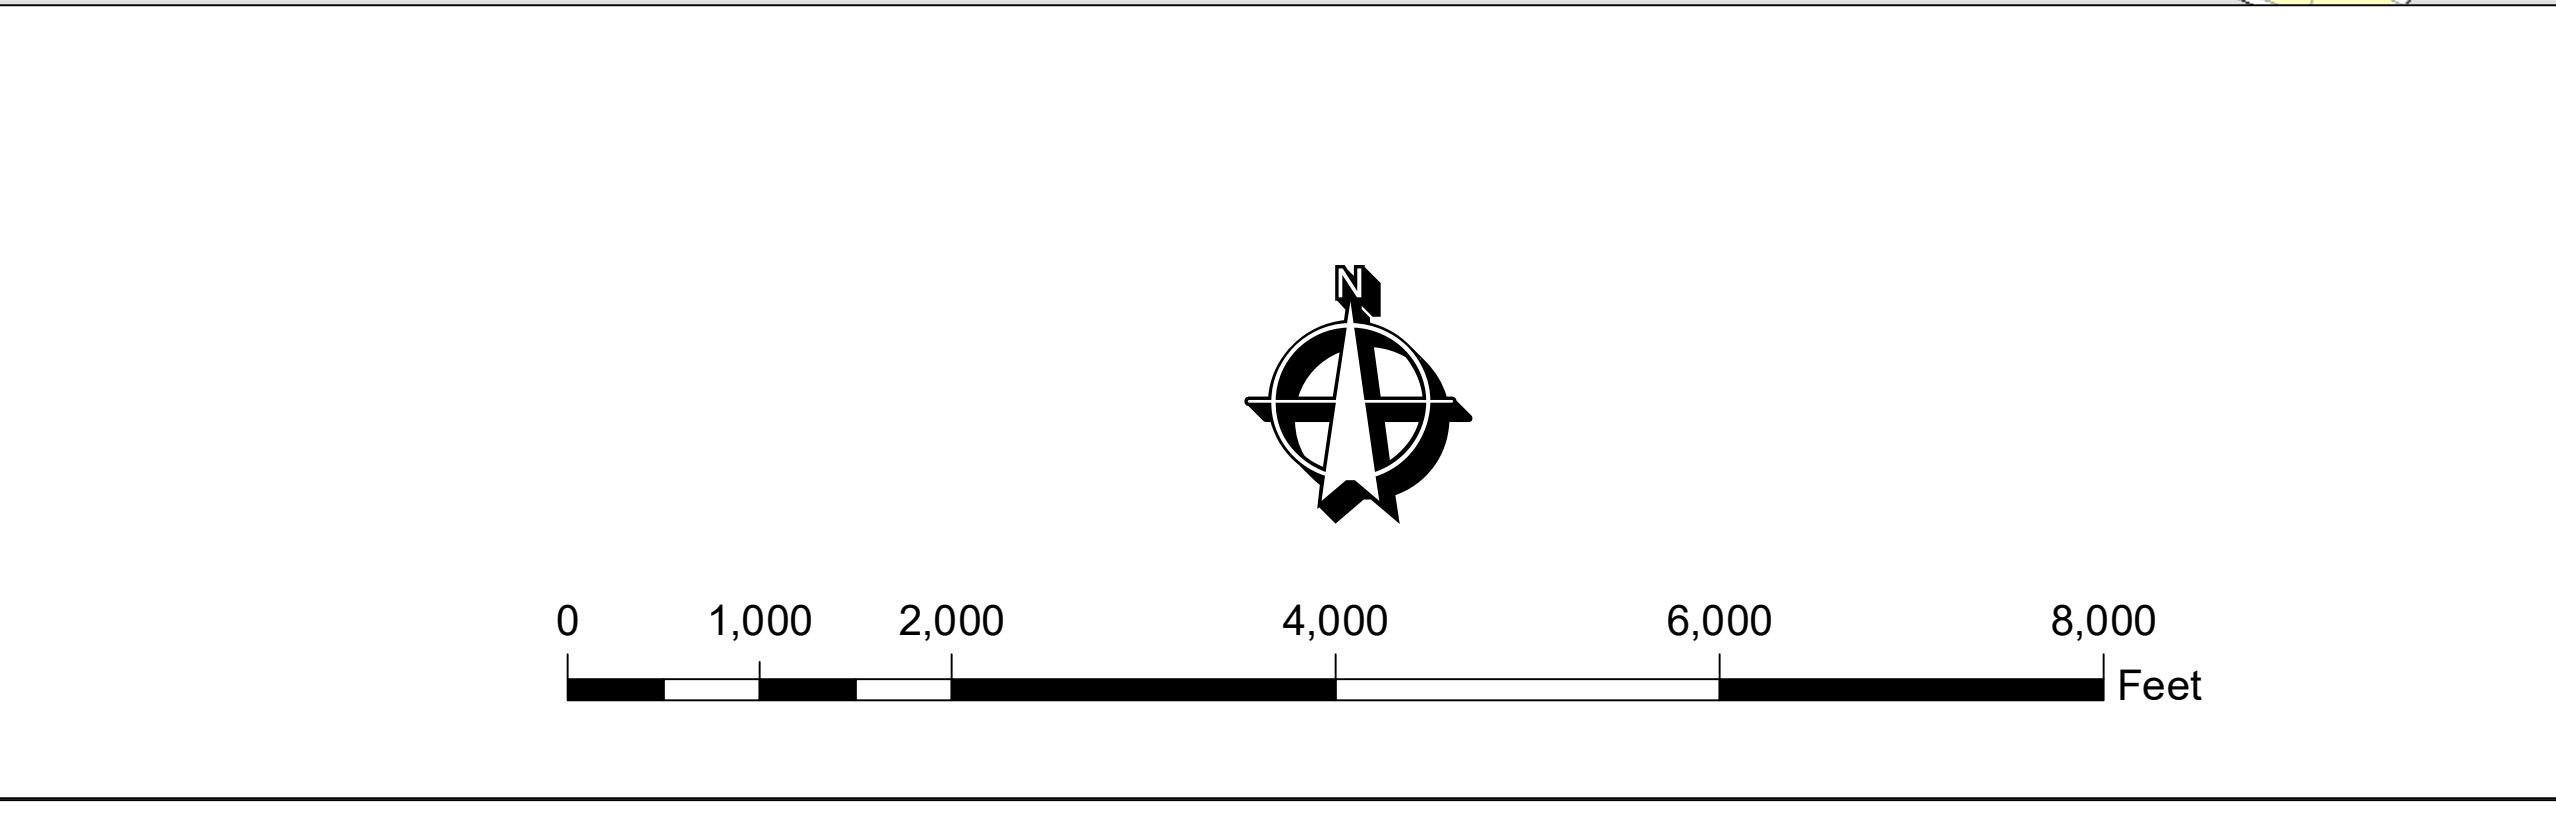


Legend

- Existing Gravity Sewer
- Existing Force Main
- C & D Growth Areas
- Parcel Boundaries
- R-80 Zoning (Not Considered for Sewers)
- Parcels Reporting Problems with Disposal System
- Parcels Reporting No Problems with Disposal System
- Undeveloped Properties
- Pump Stations
- Infill Properties (Sewer Frontage)
- Infill Properties (Town Assessed)
- Sewered Properties
- Open Space
- Special Flow

Sewer Recommendation

- Recommended
- Not Recommended

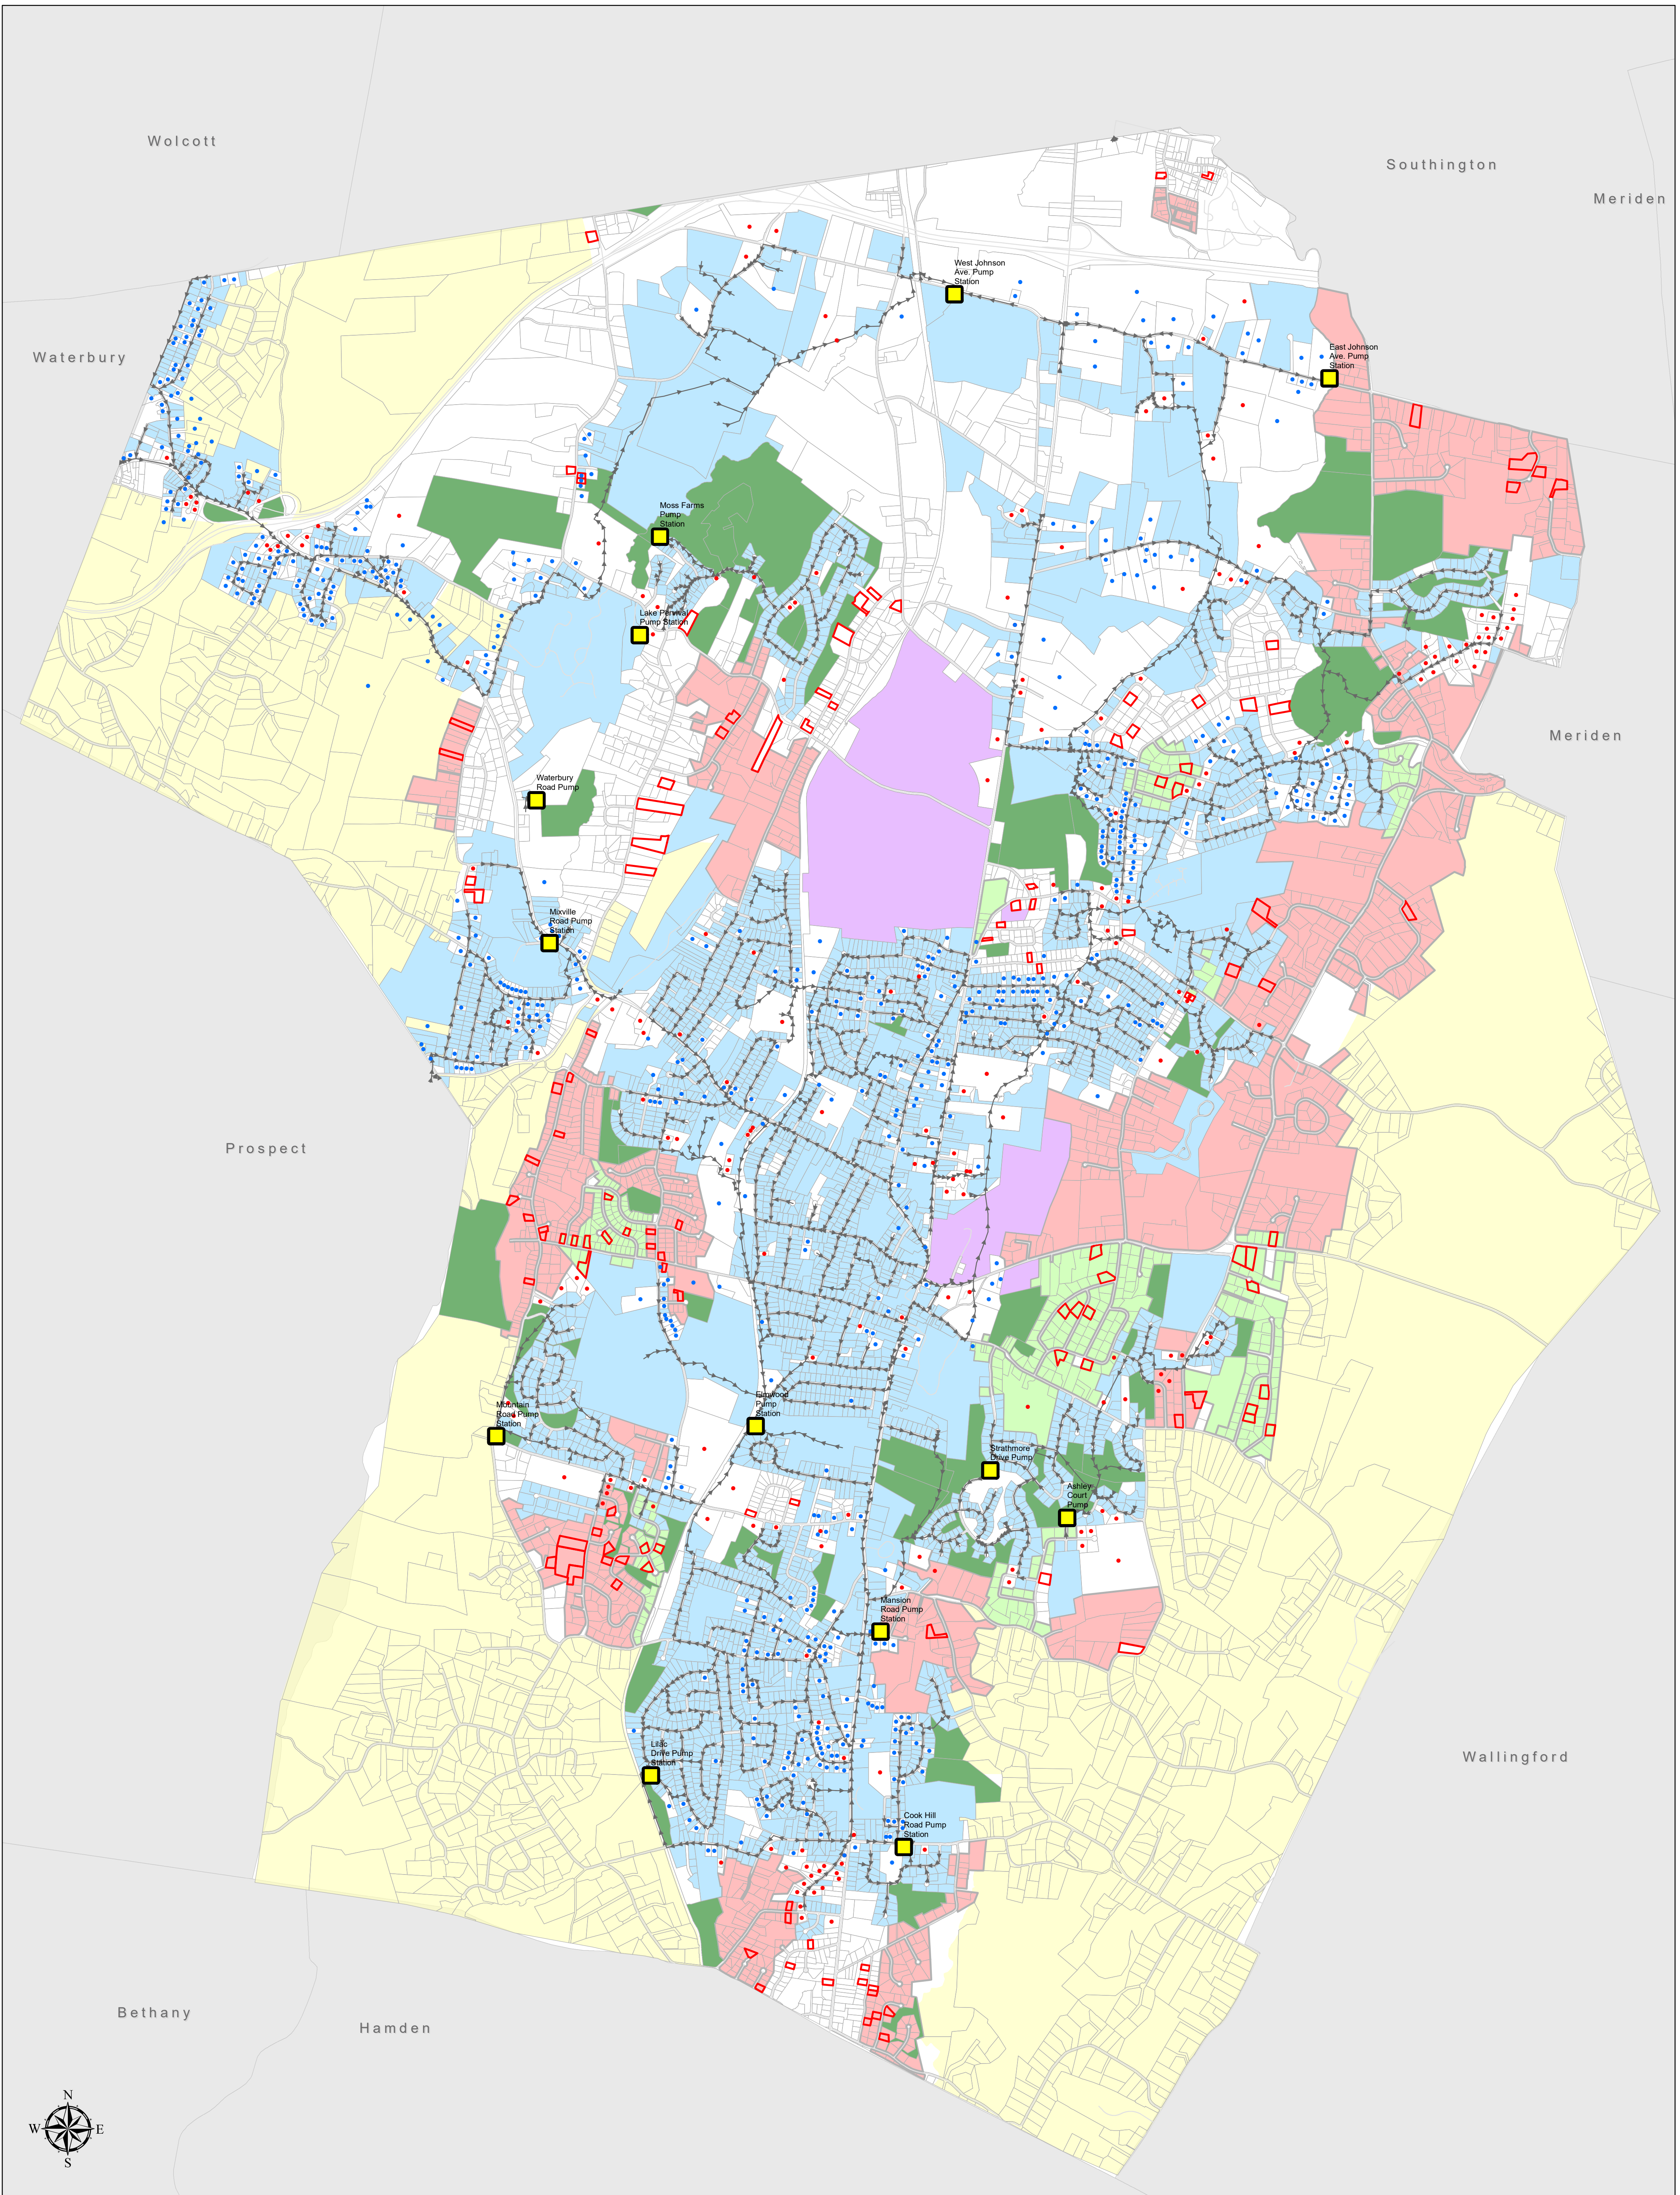


2018 Town of Cheshire Sewer Service Area



Legend

- Pump Stations
- Infill Properties (Sewer Frontage)
- Infill Properties (Town Assessed)
- Existing Force Main
- Existing Gravity Sewer
- Parcels Reporting Problems with Disposal System
- Open Space
- Special Flow
- Sewered Parcels
- Areas Not Recommended for Sewers
- Potential Sewered Parcels
- R-80 Zoning (Not Considered for Sewers)

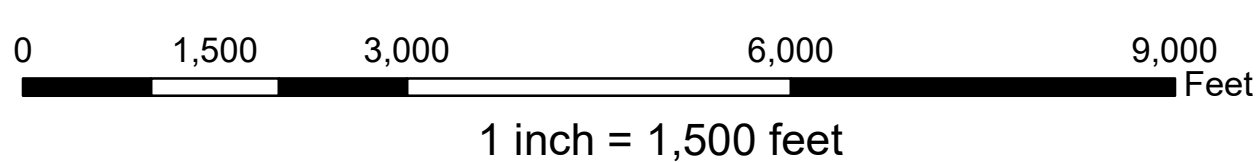

Map Produced: May 2018

RECORD DRAWING

NOTE: This Record Drawing has been prepared based on information provided by others. AECOM has not verified the accuracy and/or completeness of this information and shall not be responsible for errors or omissions which may be incorporated as a result.

I hereby certify that the Inland Wetland and Watercourse boundary line (s) shown on the map is substantially correct.


SOIL SCIENCE AND ENVIRONMENTAL SERVICES, INC.
 Kenneth C. Stevens, Jr.
 Registered Professional Soil Scientist
 Date: 2-20-2013

STRUCTURE DESIGNATION LEGEND	
10	INFLUENT PUMP STATION
11	AERATED GRIT CHAMBER
20	PRIMARY SETTLING TANKS
30	AERATION TANKS
40	OPERATIONS BUILDING
50	FINAL SETTLING TANKS
60	FORMER CHLORINE CONTACT TANK (NEW COAGULATION/FLOCCULATION TANK)
62	REAERATION TANK
64	DISC FILTER AND UV DISINFECTION BUILDING
66	EFFLUENT PUMP STATION
70	SLUDGE DEWATERING AND CHEMICAL BUILDING
72	GRAVITY THICKENER
80	DIGESTION CONTROL BUILDING
90	ADMINISTRATION BUILDING
92	DENITRIFICATION BUILDING
94	STANDBY GENERATOR AND SWITCHGEAR BUILDING
95	MISCELLANEOUS STRUCTURES

REVISIONS	DATE	MADE BY	CHECKED BY	DESCRIPTION
1	5/5/17	BS	MF	REVISED FOR RECORD DRAWINGS


AECOM

AECOM TECHNICAL SERVICES, INC.
 200 WEST 10TH AVENUE, SUITE 1000
 DENVER, COLORADO 80202
 PHONE (970) 905-1100

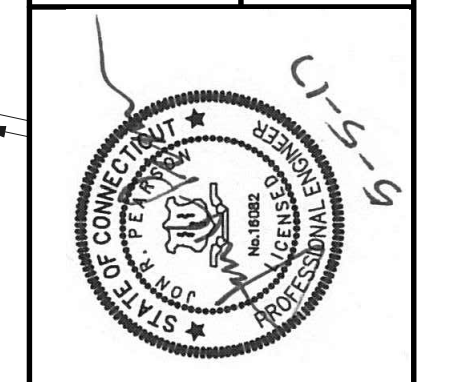


TOWN OF CHESHIRE, CONNECTICUT
 CHESHIRE WPCP UPGRADE
OVERALL SITE PLAN
 GENERAL

PROJECT NO: 60197025
 CAD DWG FILE: 00 G-004
 DESIGNED BY: J. TRAINOR
 DRAWN BY: S. NAPOLITANO
 DEPT CHECK: C. BENZIGER
 PROJ CHECK: M. FORMICA
 DATE: MAY 2013
 SCALE: AS NOTED
00 G-004
 SHEET OF

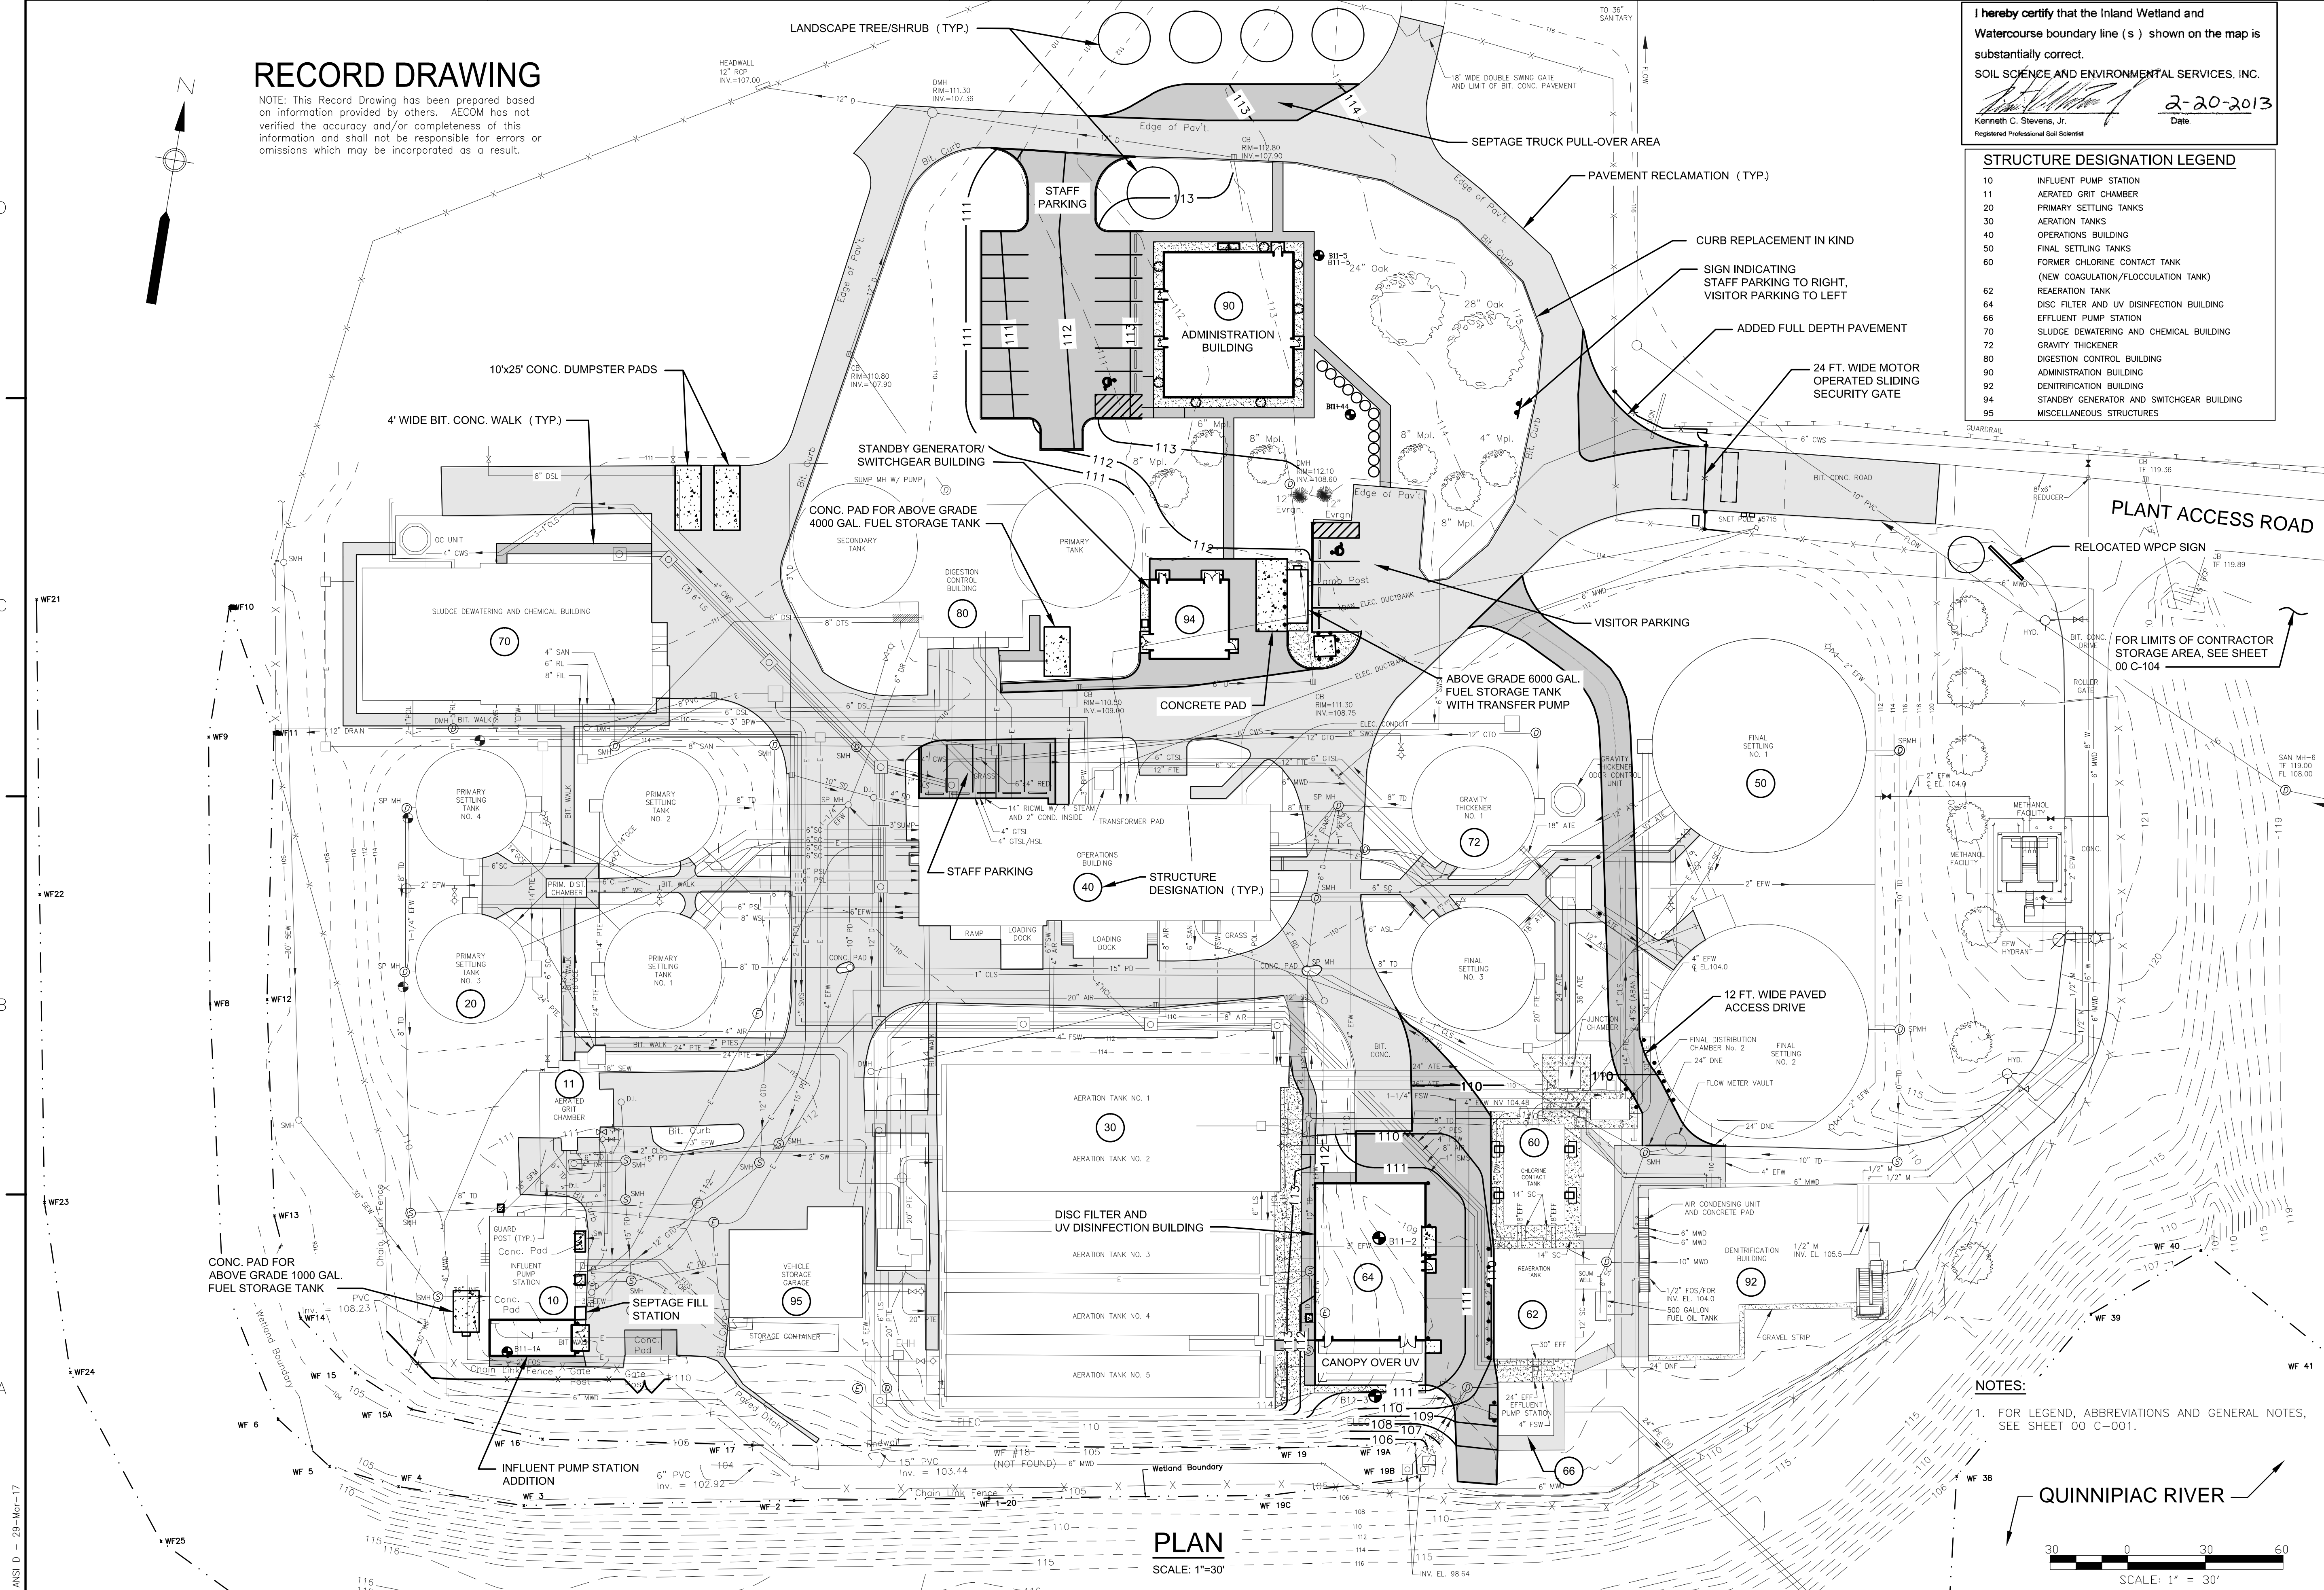


NOTES:
 1. FOR LEGEND, ABBREVIATIONS AND GENERAL NOTES, SEE SHEET 00 C-001.

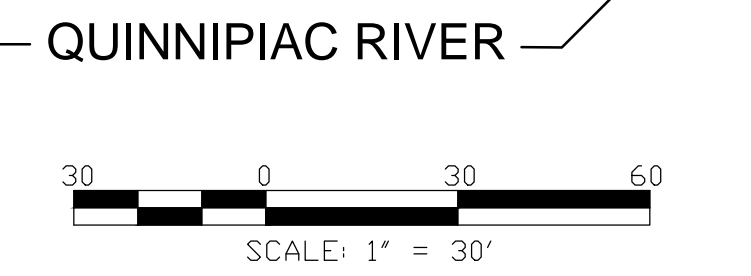

PLAN
 SCALE: 1"=30'

PATH/FILENAME: P:\60197025 - CHESHIRE WPCP UPGRADE\SHEETS\00 G-004.DWG
 LAST UPDATE: Wednesday, March 29, 2017 4:39:05 PM
 PLOT DATE: Tuesday, May 09, 2017 1:53:39 PM
 ANSI D - 29-Mar-17

PATH/FILENAME: P:\60197025 - CHESHIRE WPCP UPGRADE\SHEETS\00 G-005.DWG
 LAST UPDATE: Friday, March 17, 2017 12:18:15 PM
 PLOT DATE: Tuesday, May 09, 2017 15:42 PM
 ANSI D - 17-Mar-17

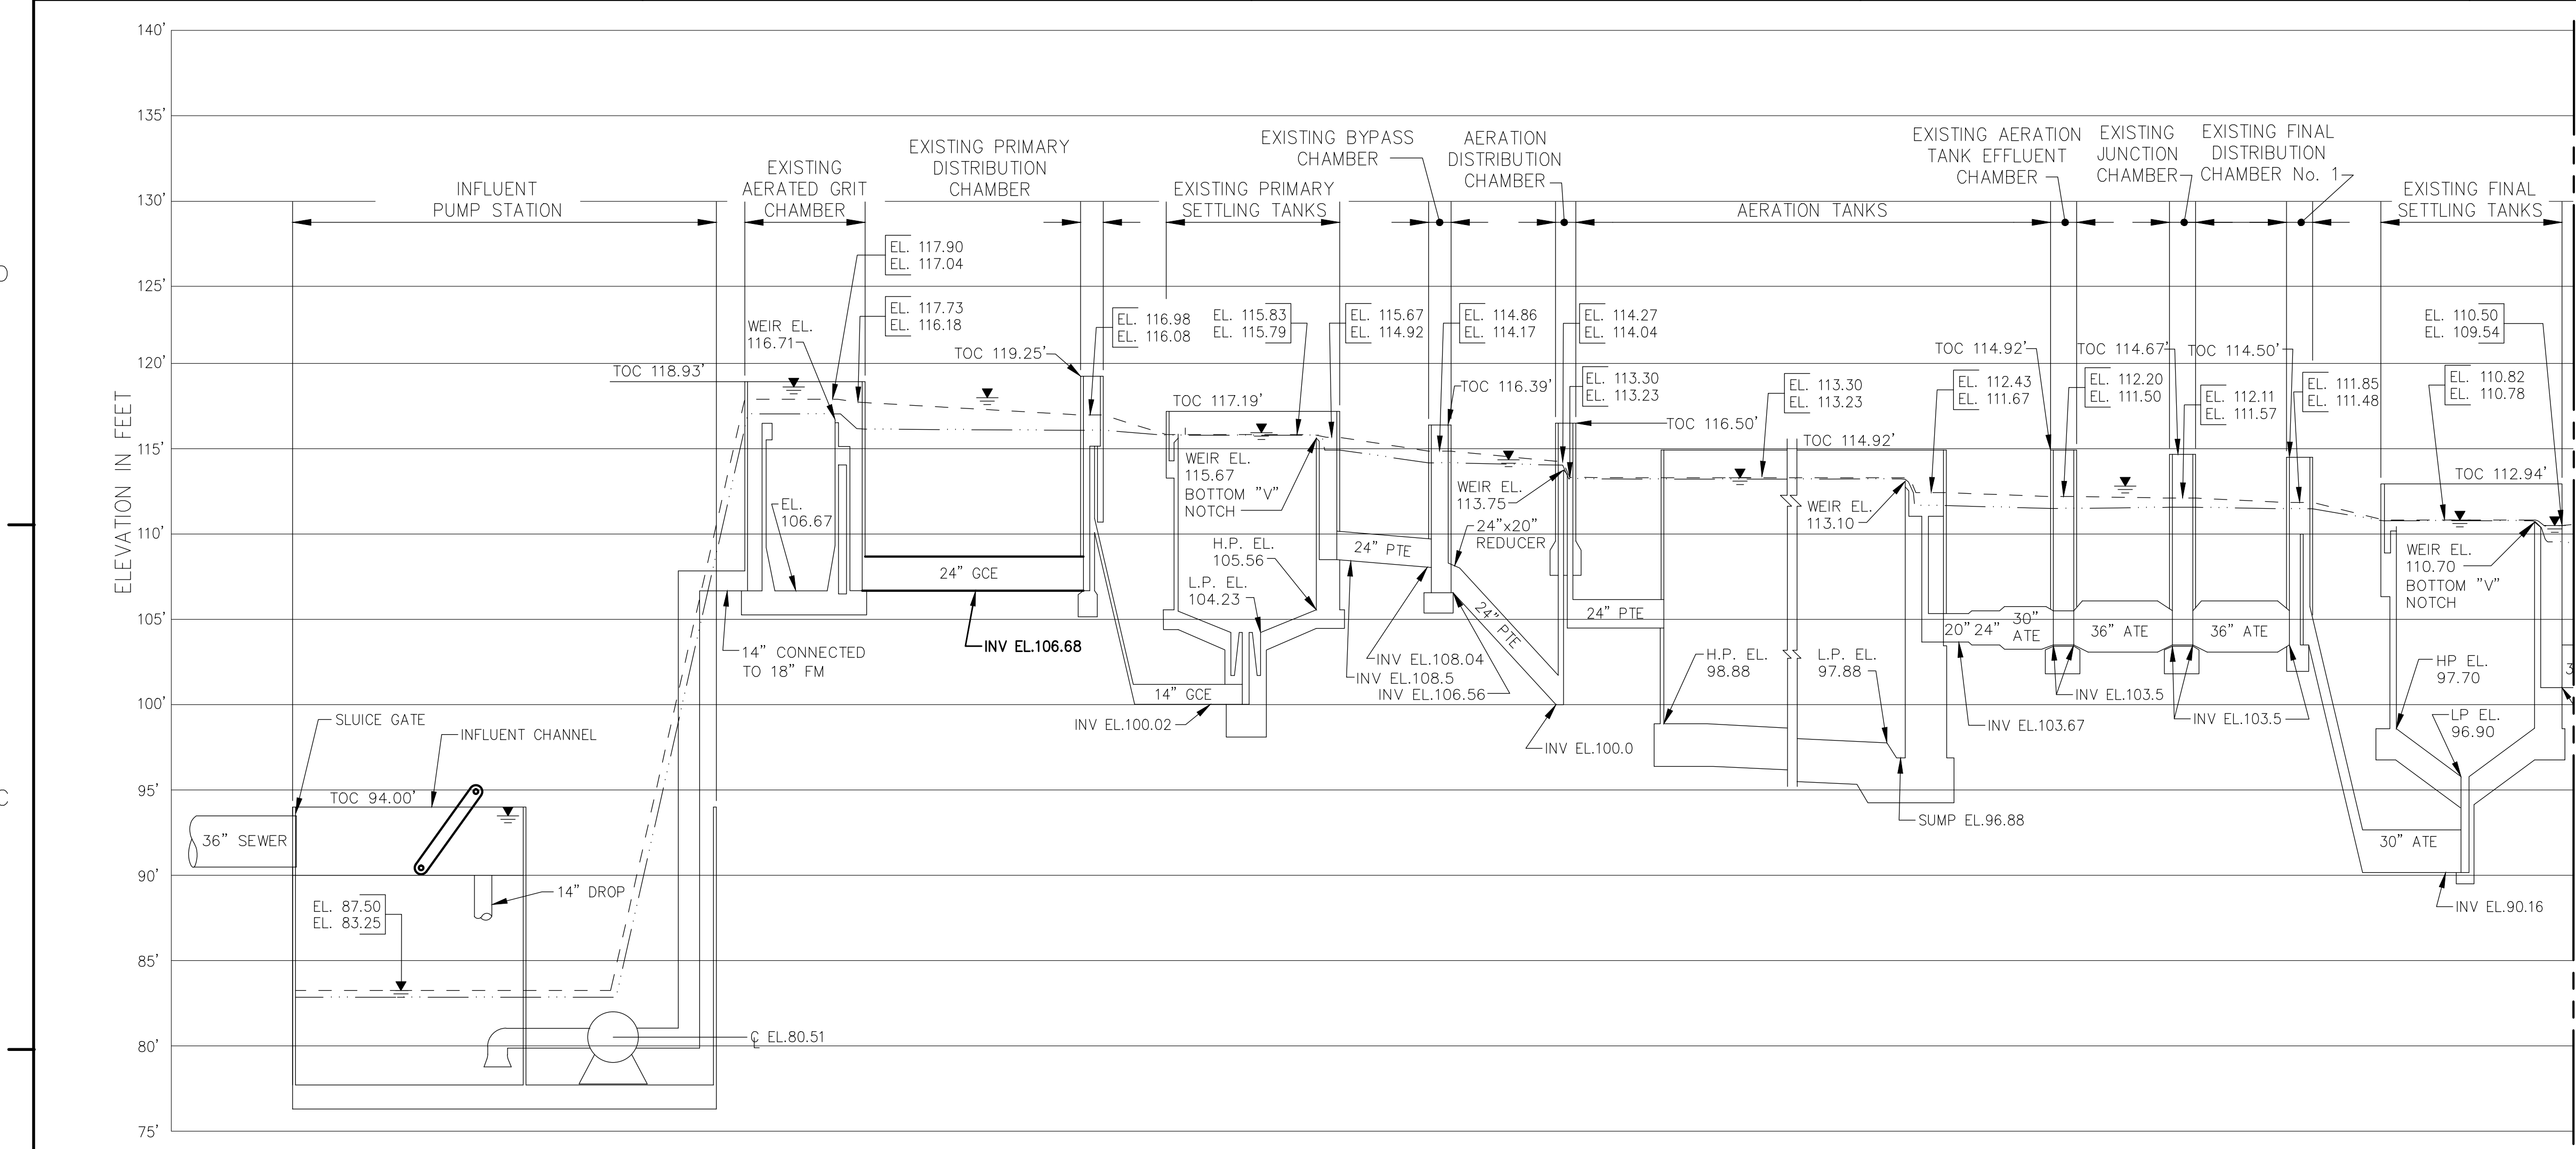

BASIS OF HYDRAULIC PROFILE

	DESIGN AVERAGE DAILY	DESIGN PEAK HOUR
FLOW (MGD)	4.0	11.0
RETURN SLUDGE (MGD)	4.0	4.32
RECYCLES (MGD)	0.3	0.3
UNITS IN SERVICE		
GRIT CHAMBERS	2	2
PRIMARY SETTLING TANKS	4	3
AERATION TANKS	5	4
FINAL SETTLING TANKS	2	2
DN FILTERS	5	5
DISC FILTERS	2	2
UV CHANNELS	1	1

- NOTES:**
- PROFILES COMPUTED ALONG PATH OF GREATEST HEAD LOSS.
 - ELEVATIONS INDICATED REFER TO USGS MEAN SEA LEVEL DATUM. FINAL SETTLING TANK EQUIPMENT TO BE SIZED BASED ON THE RETURN SLUDGE RATES SPECIFIED IN SECTION 11539

LEGEND

- EL. DESIGN PEAK
- EL. DESIGN AVERAGE
- EXISTING STRUCTURE/PIPE
- NEW STRUCTURE/PIPE
- HYDRAULIC GRADE LINE AT DESIGN PEAK FLOW
- HYDRAULIC GRADE LINE AT DESIGN AVERAGE FLOW

- NOTES:**
- FOR LEGEND, ABBREVIATIONS AND GENERAL NOTES, SEE SHEET 00 C-001.

HORIZONTAL SCALE: NONE
 VERTICAL SCALE: 1"=6'
 SCALE 0 6 12 18 FEET



RECORD DRAWING

NOTE: This Record Drawing has been prepared based on information provided by others. AECOM has not verified the accuracy and/or completeness of this information and shall not be responsible for errors or omissions which may be incorporated as a result.

NO.	DATE	BY	CHKD	DESCRIPTION
1	5/5/17	BS	MF	REVISED FOR RECORD DRAWINGS

AECOM TECHNICAL SERVICES, INC.
 200 WEST 10TH AVENUE, SUITE 1000
 DENVER, COLORADO 80202
 PHONE (970) 405-1100

AECOM

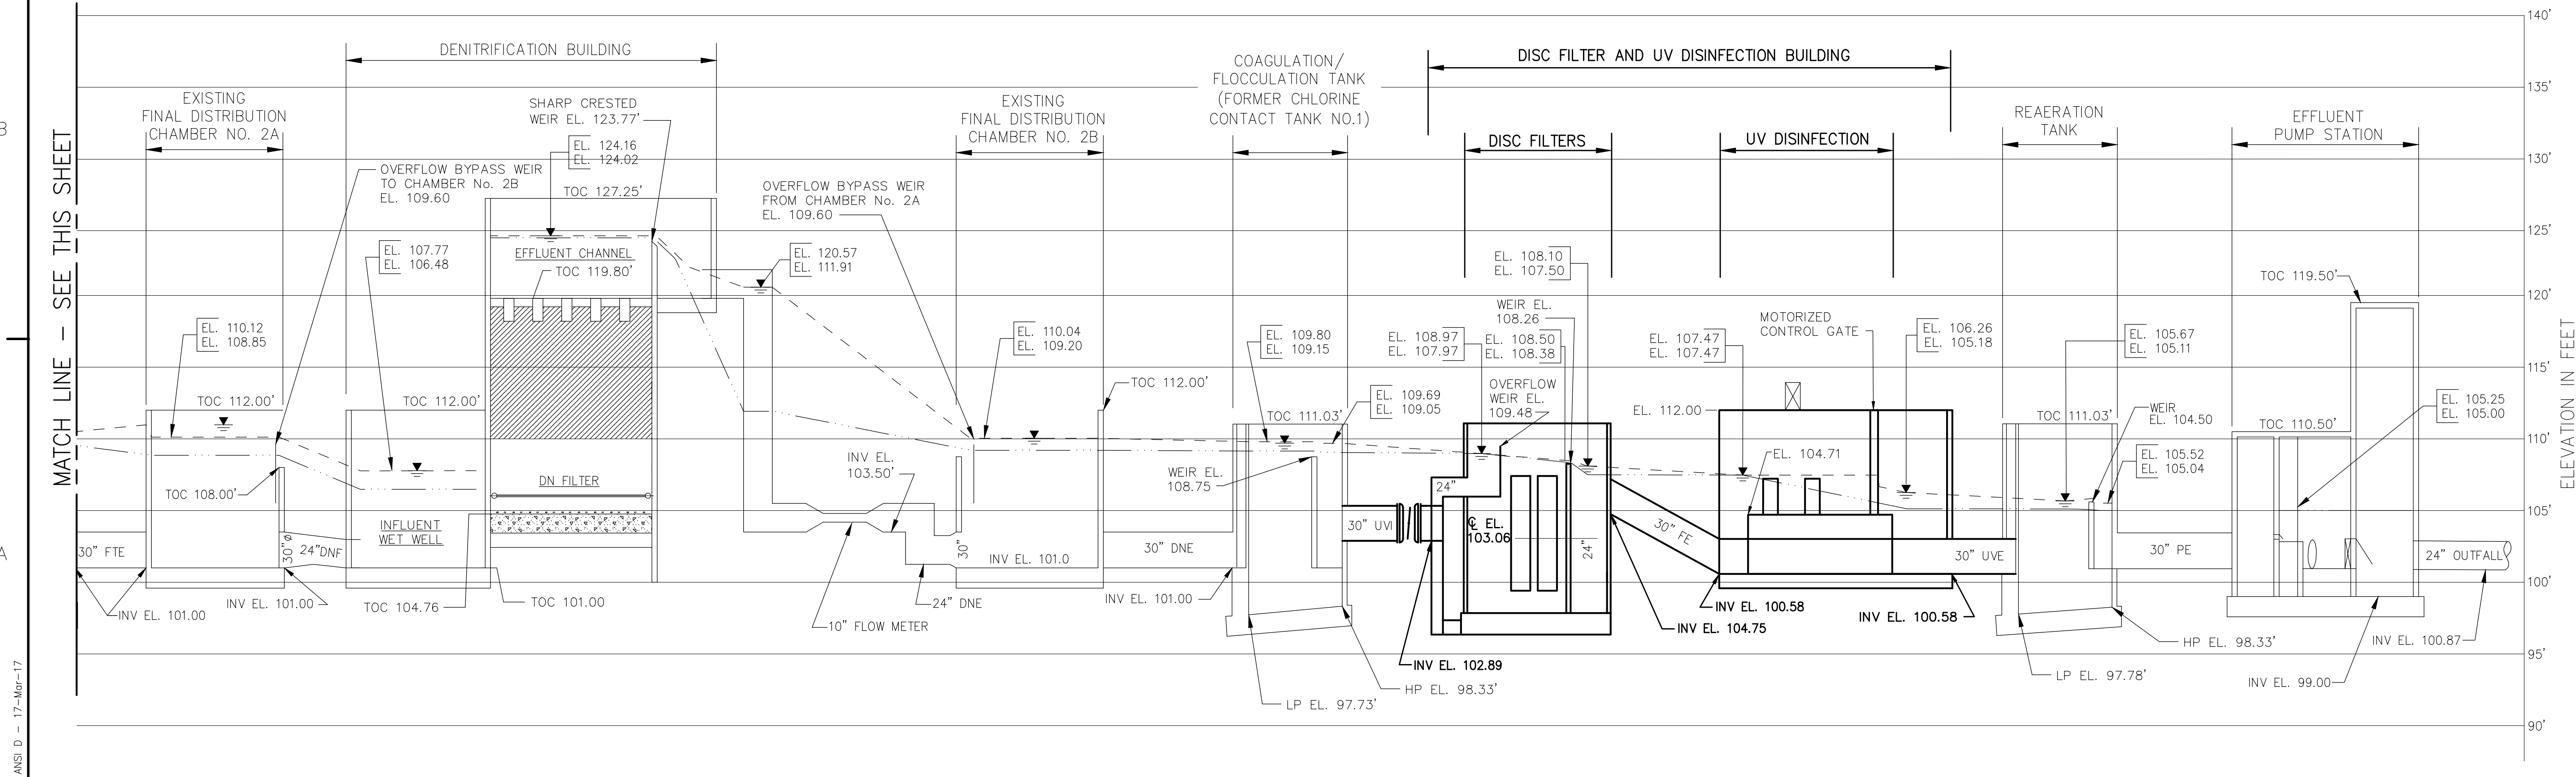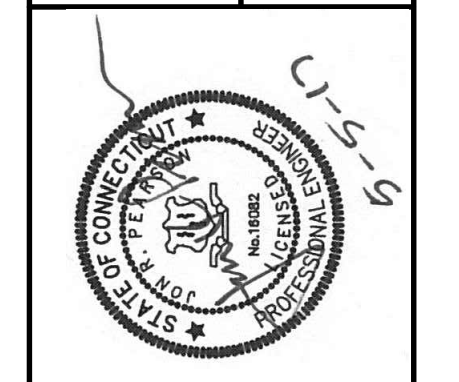

TOWN OF CHESHIRE, CONNECTICUT
 CHESHIRE WPCP UPGRADE

HYDRAULIC PROFILE

GENERAL

PROJECT NO:	60197025
CAD DWG FILE:	00 G-005
DESIGNED BY:	J. TRAINOR
DRAWN BY:	S. NAPOLITANO
DEPT CHECK:	C. ZWISGER
PROJ CHECK:	M. FORMICA
DATE:	MAY 2013
SCALE:	AS NOTED
00 G-005	
SHEET	OF

GENERAL NOTES:

- 1. TOPOGRAPHY AND EXISTING SITE INFORMATION SHOWN ON THE PLANS IS BASED ON FIELD SURVEY PROVIDED BY AI ENGINEERS, MIDDLETOWN, CT., MAY, 2011. THE REFERENCE HORIZONTAL DATUM IS ASSUMED. THE REFERENCE VERTICAL DATUM IS USGS MEAN SEA LEVEL DATUM DATED 1929. ELEVATIONS ARE IN FEET.
2. PROJECT ELEVATIONS ARE BASED ON CGS BENCHMARK #1026. THE CONTRACTOR IS RESPONSIBLE FOR VERIFYING THE ACCURACY OF ALL BENCHMARK ELEVATIONS.
3. PROPERTY LINES SHOWN ARE APPROXIMATE ONLY.
4. IT SHALL BE THE CONTRACTOR'S RESPONSIBILITY TO VERIFY ALL EXISTING CONDITIONS AT THE SITE.
5. BORING LOCATIONS ARE SHOWN ON THE PLANS. BORING LOGS ARE PROVIDED IN APPENDIX TO THE SPECIFICATIONS.
6. THE WETLANDS SHOWN WERE FIELD LOCATED AND FLAGGED IN THE FIELD BY SOIL SCIENCE AND ENVIRONMENTAL SERVICES, CHESHIRE, CT., MARCH, 2011.
7. THE CONTRACTOR SHALL ERECT EROSION CONTROL MEASURES PRIOR TO COMMENCING ANY EXCAVATION OR STORAGE OF BACKFILL MATERIAL ON-SITE. REFER TO SPECIFICATION SECTION 01568 AND CIVIL DETAILS.
8. THE CONTRACTOR SHALL TAKE ALL NECESSARY MEASURES AND SHALL PROVIDE ALL NECESSARY CONTINUOUS BARRIERS OF SUFFICIENT TYPE, SIZE AND STRENGTH TO PREVENT ACCESS TO OPEN EXCAVATIONS AT THE COMPLETION OF EACH DAY'S WORK.
9. IT SHALL BE THE CONTRACTOR'S RESPONSIBILITY TO PERFORM ALL WORK AS INDICATED ON THE DRAWINGS, IN THE SPECIFICATIONS AND AS DIRECTED BY THE ENGINEER IN CONFORMANCE WITH ALL APPLICABLE CODES IN A PROPER AND WORKMANLIKE MANNER.
10. THE ENGINEER MAY DIRECT THE CONTRACTOR TO VARY THE PROPOSED WORK DURING CONSTRUCTION TO MEET EXISTING CONDITIONS.
11. ALL CONSTRUCTION ACTIVITY SHALL BE CONFINED TO THE AREA WITHIN THE LIMIT OF WORK AS SHOWN ON THE SITE PLAN.
12. NO EQUIPMENT, VEHICLES OR CONSTRUCTION MATERIALS SHALL BE STORED OUTSIDE OF DESIGNATED WORK AREAS DURING EITHER WORKING OR NON-WORKING HOURS. THE LOCATION FOR ANY STORAGE OF EQUIPMENT BY THE CONTRACTOR DURING NON-WORKING HOURS SHALL BE AS APPROVED BY OWNER.
13. WORKING HOURS WITHIN THE TOWN ARE 7:00 A.M. TO 4:00 P.M., MONDAY THROUGH FRIDAY. PERMISSION IS REQUIRED FROM THE TOWN VIA THE ENGINEER TO WORK ON SATURDAY, SUNDAY, LEGAL HOLIDAYS, OR ANY WEEKDAY NIGHT PAST THE HOURS SPECIFIED. THIS PERMISSION MUST BE REQUESTED 72 HOURS IN ADVANCE. SUNDAY WORK WILL ONLY BE ALLOWED IN CASE OF EMERGENCY.
14. THE CONTRACTOR IS RESPONSIBLE FOR THE PROTECTION OF THE EXISTING FEATURES AND STRUCTURES WITHIN AND ADJACENT TO THE WORK. ANY ITEM DISTURBED OR IN CONFLICT WITH THE PROPOSED WORK SHALL BE REMOVED AND RESET OR REPLACED AT THE CONTRACTOR'S EXPENSE. IN THE EVENT OF DAMAGE, THE REPAIRS OR REPLACEMENT SHALL BE COMPLETED AT THE CONTRACTOR'S EXPENSE AS APPROVED BY THE ENGINEER.
15. THE CONTRACTOR SHALL PERFORM CLEARING AND GRUBBING AS NECESSARY TO CONSTRUCT THE WORK AS SHOWN ON DRAWINGS. NO TREES OR TREE LIMBS SHALL BE CUT UNLESS DIRECTED BY THE ENGINEER.
16. THE CONTRACTOR SHALL BE RESPONSIBLE FOR CONTINUOUS CLEANING OF MUD, DIRT AND DEBRIS OFF STREETS, WHEN SUCH MUD, DIRT OR DEBRIS IS DEPOSITED THERE AS A RESULT OF HIS CONSTRUCTION ACTIVITY. ANY DEBRIS, MUD, OR DELETERIOUS MATERIAL FROM THE PROJECT WILL BE REMOVED FROM THE STREET AND SURROUNDING STREETS BY CONTRACTOR AT THE END OF EACH WORKING DAY, OR BEFORE, IF DIRECTED BY THE OWNER OR ENGINEER.
17. USE WATER SPRINKLING, TEMPORARY ENCLOSURES AND OTHER SUITABLE METHODS TO LIMIT DUST AND DIRT RISING AND SCATTERING IN THE AIR.
18. THE CONTRACTOR SHALL BE RESPONSIBLE FOR SECURING A SITE FOR DISPOSAL OF ALL EXCAVATED UNACCEPTABLE MATERIAL THAT IS UNSUITABLE FOR USE AS BACKFILL AND ALL OTHER EXCESS EXCAVATED MATERIALS. THE CONTRACTOR SHALL PROVIDE THE ENGINEER WITH THE LOCATION OF THE DISPOSAL SITE AND WRITTEN PERMISSION FOR USE OF THE SITE FROM THE PROPERTY OWNER. THE COST FOR SECURING AND MAINTAINING THE DISPOSAL SITE SHALL BE THE CONTRACTOR'S RESPONSIBILITY.
19. ROCK REMOVAL BY THE MECHANICAL METHOD SHALL CONSIST OF CUTTING AWAY ROCK AT TRENCH BOTTOM TO FORM A LEVEL BEARING SURFACE 6" BELOW INVERT ELEVATION OF PIPE.
20. ALL UNEXCAVATED ROCK WITHIN 3'-0" HORIZONTALLY OF THE ENDS OF BUILDING CONNECTIONS, BRANCHES AND STUBS, AND DOWN TO A HORIZONTAL PLANE 6-INCHES BELOW THE BOTTOMS OF SUCH CONNECTIONS, BRANCHES AND STUBS, SHALL BE REMOVED.
21. ALL EXCESS SOIL FROM CONSTRUCTION TO BE STOCKPILED OUTSIDE OF 100 FOOT BUFFER ZONE. DISPOSE OF EXCESS AND UNSUITABLE MATERIAL IN ACCORDANCE WITH SPECIFICATION SECTION 01110.
22. IF AT ANY TIME THE CONSTRUCTION EXCAVATION REVEALS ANY ARTICLE OF HISTORIC OR ARCHEOLOGICAL SIGNIFICANCE, WORK AT THE LOCATION WILL CEASE AND THE CONTRACTOR SHALL IMMEDIATELY NOTIFY THE ENGINEER.
23. THE CONTRACTOR IS RESPONSIBLE FOR RESTORING UNPAVED AREAS DISTURBED BY THE CONTRACTOR TO ORIGINAL CONDITIONS INCLUDING ALL GRADING, LOAMING, SEEDING, ETC. ASSOCIATED WITH CONSTRUCTION.
24. EXCAVATION OF ANY TYPE SHALL BE ACCOMPLISHED IN SUCH A MANNER THAT UNDERGROUND UTILITIES OR STRUCTURES ARE NOT DAMAGED. ALL ROADWAYS, PARKING AREAS, SIDEWALKS AND OTHER STRUCTURES DISTURBED BY CONSTRUCTION IN OR OUTSIDE THE PROJECT AREA SHALL BE RETURNED TO THEIR ORIGINAL CONDITION OR BETTER AND SHALL BE GRADED TO MEET PROPOSED CONSTRUCTION AS DIRECTED BY THE ENGINEER. ALL COSTS RELATED TO THE REPAIR OF DAMAGED UTILITIES OR STRUCTURES SHALL BE BORNE BY THE CONTRACTOR.
25. EXISTING TREES, BUSHES AND SHRUBS SHALL BE PROTECTED BY THE CONTRACTOR FROM ALL DAMAGE UNLESS IN DIRECT CONFLICT WITH PROPOSED STRUCTURES, ROADWAYS, ETC. REFER TO SPECIFICATION SECTION 01110 - ENVIRONMENTAL PROTECTION PROCEDURES, AND SECTION 01046, CONTROL OF WORK WITH REGARD TO PROTECTION OF LAND RESOURCES.
26. ALL BUILDINGS, STRUCTURES AND ROADWAYS SHALL BE LOCATED OFF THE BASELINES DEFINED ON THE CIVIL LAYOUT PLANS.
27. ALL LAYOUT DIMENSIONS REFER TO OUTSIDE FACE OF STRUCTURE AT GRADE LINE, UNLESS OTHERWISE NOTED.
28. WITHIN THE LIMITS INDICATED ON THE DRAWINGS, THE CONTRACTOR SHALL PROVIDE COMPLETE PAVEMENT OVERLAY, PAVEMENT RECLAMATION OR NEW PAVEMENT IN ACCORDANCE WITH THE DRAWINGS AND DETAILS. FOR ADDITIONAL REQUIREMENTS, REFER TO THE SPECIFICATIONS.
29. PROVIDE UNIFORM SLOPE OF ROADWAY BETWEEN ELEVATIONS INDICATED ON THE PLANS. ALL ROADWAYS SHALL BE GRADED AT 1/4" PER FOOT UNLESS OTHERWISE INDICATED BY SPOT ELEVATIONS OR CONTOURS.
30. THE CONTRACTOR SHALL FILL AND GRADE AREAS ADJACENT TO NEW CONSTRUCTION FOR POSITIVE DRAINAGE AS DIRECTED BY THE ENGINEER.
31. ALL COVERS, FRAMES AND GRATES FROM UTILITY STRUCTURES WHICH ARE ABANDONED UNDER THIS CONTRACT SHALL BE PROTECTED FROM DAMAGE AND TURNED OVER TO THE OWNER.
32. ALL UTILITY COVERS, BOXES, FRAMES AND GRATES, ETC. NOT TO BE ABANDONED BY THIS CONTRACT SHALL BE RESET TO FINAL GRADE.
33. THERE ARE NUMEROUS REQUIREMENTS INVOLVING WORK SEQUENCE. REFER TO SPECIFICATION SECTION 01015 FOR DETAILED REQUIREMENTS.

YARD PIPING NOTES:

- 1. EXISTING PIPING, CONDUITS, AND STRUCTURES SHALL BE REMOVED OR ABANDONED AS REQUIRED TO COMPLETE THE PROPOSED WORK UNLESS SHOWN OTHERWISE ON THE DRAWINGS OR DIRECTED BY THE ENGINEER.
2. ALL ABANDONED PIPES SHALL BE DISCONNECTED AT THE OUTSIDE WALL OF THE STRUCTURE. ALL OPEN ENDS OF ABANDONED PIPES SHALL BE PLUGGED AS DIRECTED.
3. LOCATIONS OF EXISTING PIPING ARE FROM THE BEST INFORMATION AVAILABLE. EXACT LOCATIONS AND COMPLETENESS ARE NOT GUARANTEED. ELEVATION AND DIRECTION OF NEW YARD PIPING ARE SHOWN FOR THE PURPOSE OF INDICATING THE BASIC PARAMETERS USED DURING DESIGN. THE CONTRACTOR SHALL MAKE TEST PITS AS REQUIRED IN ORDER TO DETERMINE THE EXACT LOCATION OF EXISTING PIPES. CONTRACTOR SHALL ALSO MAKE ALL REQUIRED FIELD MEASUREMENTS TO VERIFY EXISTING AND CONTRACT INTERFACE DIMENSIONS, LOCATIONS, AND OTHER CONDITIONS. FINAL LOCATIONS OF PIPES WILL BE DETERMINED IN THE FIELD. ANY CHANGES SHALL BE APPROVED BY THE ENGINEER/OWNER.
4. ALL PIPES SHALL SLOPE UNIFORMLY BETWEEN ELEVATIONS SHOWN ON MECHANICAL DRAWINGS UNLESS OTHERWISE INDICATED ON THE DRAWINGS OR DIRECTED BY THE ENGINEER. NO SAGS OR CRESTS IN PIPING WILL BE PERMITTED.
5. JOINTS SHALL BE PROVIDED AT THE WALL OF STRUCTURES ON ALL PIPELINES, EXCEPT WHERE SLEEVES ARE INDICATED. THIS SHALL BE ACCOMPLISHED BY CASTING A BELL WALL FITTING, BELL END STUB, OR WALL CASTING INTO THE STRUCTURE. ALL WALL AND SLAB PENETRATIONS SHALL BE SEALED WATERTIGHT.
7. PIPES AT STRUCTURES SHALL HAVE EITHER TWO PIPE JOINTS, TWO SOLID SLEEVE COUPLINGS, OR ONE OF EACH WITHIN 16 FT OF THE STRUCTURE, NOT INCLUDING THE JOINT AT THE WALL OF THE STRUCTURE, EXCEPT AS INDICATED.
8. ALL PIPING EXCEPT DRAINAGE PIPING SHALL HAVE 4'-6" MINIMUM COVER UNLESS SPECIFICALLY INDICATED OTHERWISE OR DIRECTED BY THE ENGINEER.
9. FOR LOCATIONS OF PROPOSED ELECTRICAL CONDUITS, SEE ELECTRICAL DRAWINGS.
10. SEE MECHANICAL DRAWINGS FOR PIPE ELEVATIONS AT WALLS OF STRUCTURES.
11. OUTSIDE PIPING MATERIAL SHALL BE AS INDICATED AND SPECIFIED.
12. PROVIDE JOINT RESTRAINT FOR ALL NEW DUCTILE IRON PIPE, UNLESS OTHERWISE INDICATED OR DIRECTED BY THE ENGINEER.
13. PROVIDE FITTINGS AT ALL POINTS OF CONNECTION BETWEEN NEW AND EXISTING WORK.
14. ALL PIPING UNDER STRUCTURES SHALL BE ENCASED IN CONCRETE (REFER TO STRUCTURAL DETAILS).
15. REFER TO SHEET 00 D-003 FOR PIPE TESTING INFORMATION AND OTHER REQUIREMENTS.

ABBREVIATIONS

Table listing abbreviations and their descriptions, including AGCS, AIR, ALP, ASL, ATE, BPWF, BW, BWA, CA, CDW, CDWR, COWS, CHW, CHWR, CHWS, CLS, CRL, CRS, CW, CWS, D, DG, DNE, DNF, DSL, DTS, SLP, DW, EFW, FCL, FE, FES, FIL, FILL, FOR, FOS, FSW, FTE, GTDW, GTE, GTO, GTSL, HSL, HW, HWR, HWS, IA, IS, LS, M, MCW, MPL, MWD, MWO, OC, OF, PC, PD, PE, PES, POL, PSL, PSLS, PT, PTE, PTES, R, RD, REC, RL, RSL, RWS, SAM, SAN, SBW, SC, SD, SEW, SFM, SGS, SMS, SPD, SW, SWS, TD, TWAS, UV, UVE, UVI, V OR VT, VAC, WF, WSL, WW.

LEGEND

Legend table with columns for EXISTING, PROPOSED, and PROPOSED (CONT.). Includes symbols for Chain Link Metal Fence, Contour, Structure, Edge of Road, Edge of River, Wetlands Delineation, Drain Manhole, Sewer Manhole, Catch Basin, Buried Pipe with Pipe Type Designation, Utility Pole, Culvert Pipe, Guard Post, Valve Box, Vent, Fire Hydrant, Meter Vault, Water Gate Valve, Property Line, Pole and Light, Landscaping, Swing Gate, Boring with Number, Observation Well with Number, Wetland Flag and Boundary, 45' Bend, 90' Bend, Butterfly Valve, Tee, Reducer, Direction of Flow, Hydrant, Gate Valve, Manhole, Guardpost, Full Depth Bituminous Pavement Drive/Walkway, Reclaim Existing Pavement, Concrete, Mowing Strip (Gravel Surface), Contour, Spot Elevation, Erosion Control, Structure Designation, Demolition.

Vertical sidebar containing AECOM logo, project information (PROJECT NO: 60197025, CAD DWG FILE: 00 C-001, DESIGNED BY: J. TRAINOR, DRAWN BY: S. NAPOLITANO, PROJ CHECK: C. BENZIGER, DATE: MAY 2013, SCALE: AS NOTED), a circular professional seal for the State of Connecticut, and the text 'RECORD DRAWING' and '00 C-001'.

PATH/FILENAME: P:\60197025 - CHESHIRE WPCP UPGRADE\SHEETS\C00 C-001.DWG
LAST UPDATE: Friday, March 17, 2017 12:18:10 PM
PLOT DATE: Tuesday, May 09, 2017 13:54:5 PM
ANSI D - 17-Mar-17


RECORD DRAWING

NOTE: This Record Drawing has been prepared based on information provided by others. AECOM has not verified the accuracy and/or completeness of this information and shall not be responsible for errors or omissions which may be incorporated as a result.

NOTES:

- FOR LEGEND, ABBREVIATIONS AND GENERAL NOTES, SEE SHEET 00 C-001.
- FOR ADDITIONAL EROSION CONTROL AT CONTRACTOR'S STORAGE AREA, SEE SHEET 00 C-104.
- FOR DETAILS, SEE SHEETS 99 C-501 THRU 99 C-503.
- THE CONTRACTOR SHALL COORDINATE SITE ACCESS AND WORK SCHEDULE WITH CONTRACTOR OF CELL TOWER CONSTRUCTION PROJECT. PROPOSED CELL TOWER PROJECT INCLUDES CONSTRUCTION OF TOWER, IMPROVEMENTS TO GRAVEL ACCESS ROAD AND UNDERGROUND ELECTRIC AND TELEPHONE FROM TOWER TO SNET POLE #5715.
- THE CONTRACTOR SHALL INSTALL DEEP REQUIRED PROJECT SIGN ON EXISTING STEEL POSTS AT ENTRANCE TO PLANT ACCESS ROAD ON CHESHIRE STREET. REMOVE SIGN AND SUPPORT POSTS AND RESTORE DISTURBED AREA AT COMPLETION OF CONSTRUCTION.
- BASED ON HISTORICAL WPCP INFORMATION, THE LIME SILO WAS ONCE FILLED AND WAS SUBSEQUENTLY EMPTIED OF ITS CONTENTS IN THE LATE 1980'S. IT IS ANTICIPATED THAT SOME RESIDUAL LIME FROM THAT TIME REMAINS IN THE SILO. THE REMOVAL AND DISPOSAL OF THE LIME SOLO AND ITS REMAINING CONTENTS ARE TO BE CONDUCTED IN ACCORDANCE WITH ALL LOCAL, STATE AND FEDERAL REGULATIONS.


I hereby certify that the Inland Wetland and Watercourse boundary line (s) shown on the map is substantially correct.
SOIL SCIENCE AND ENVIRONMENTAL SERVICES, INC.
 Kenneth C. Stevens, Jr.
 Registered Professional Soil Scientist
 Date: **2-20-2013**

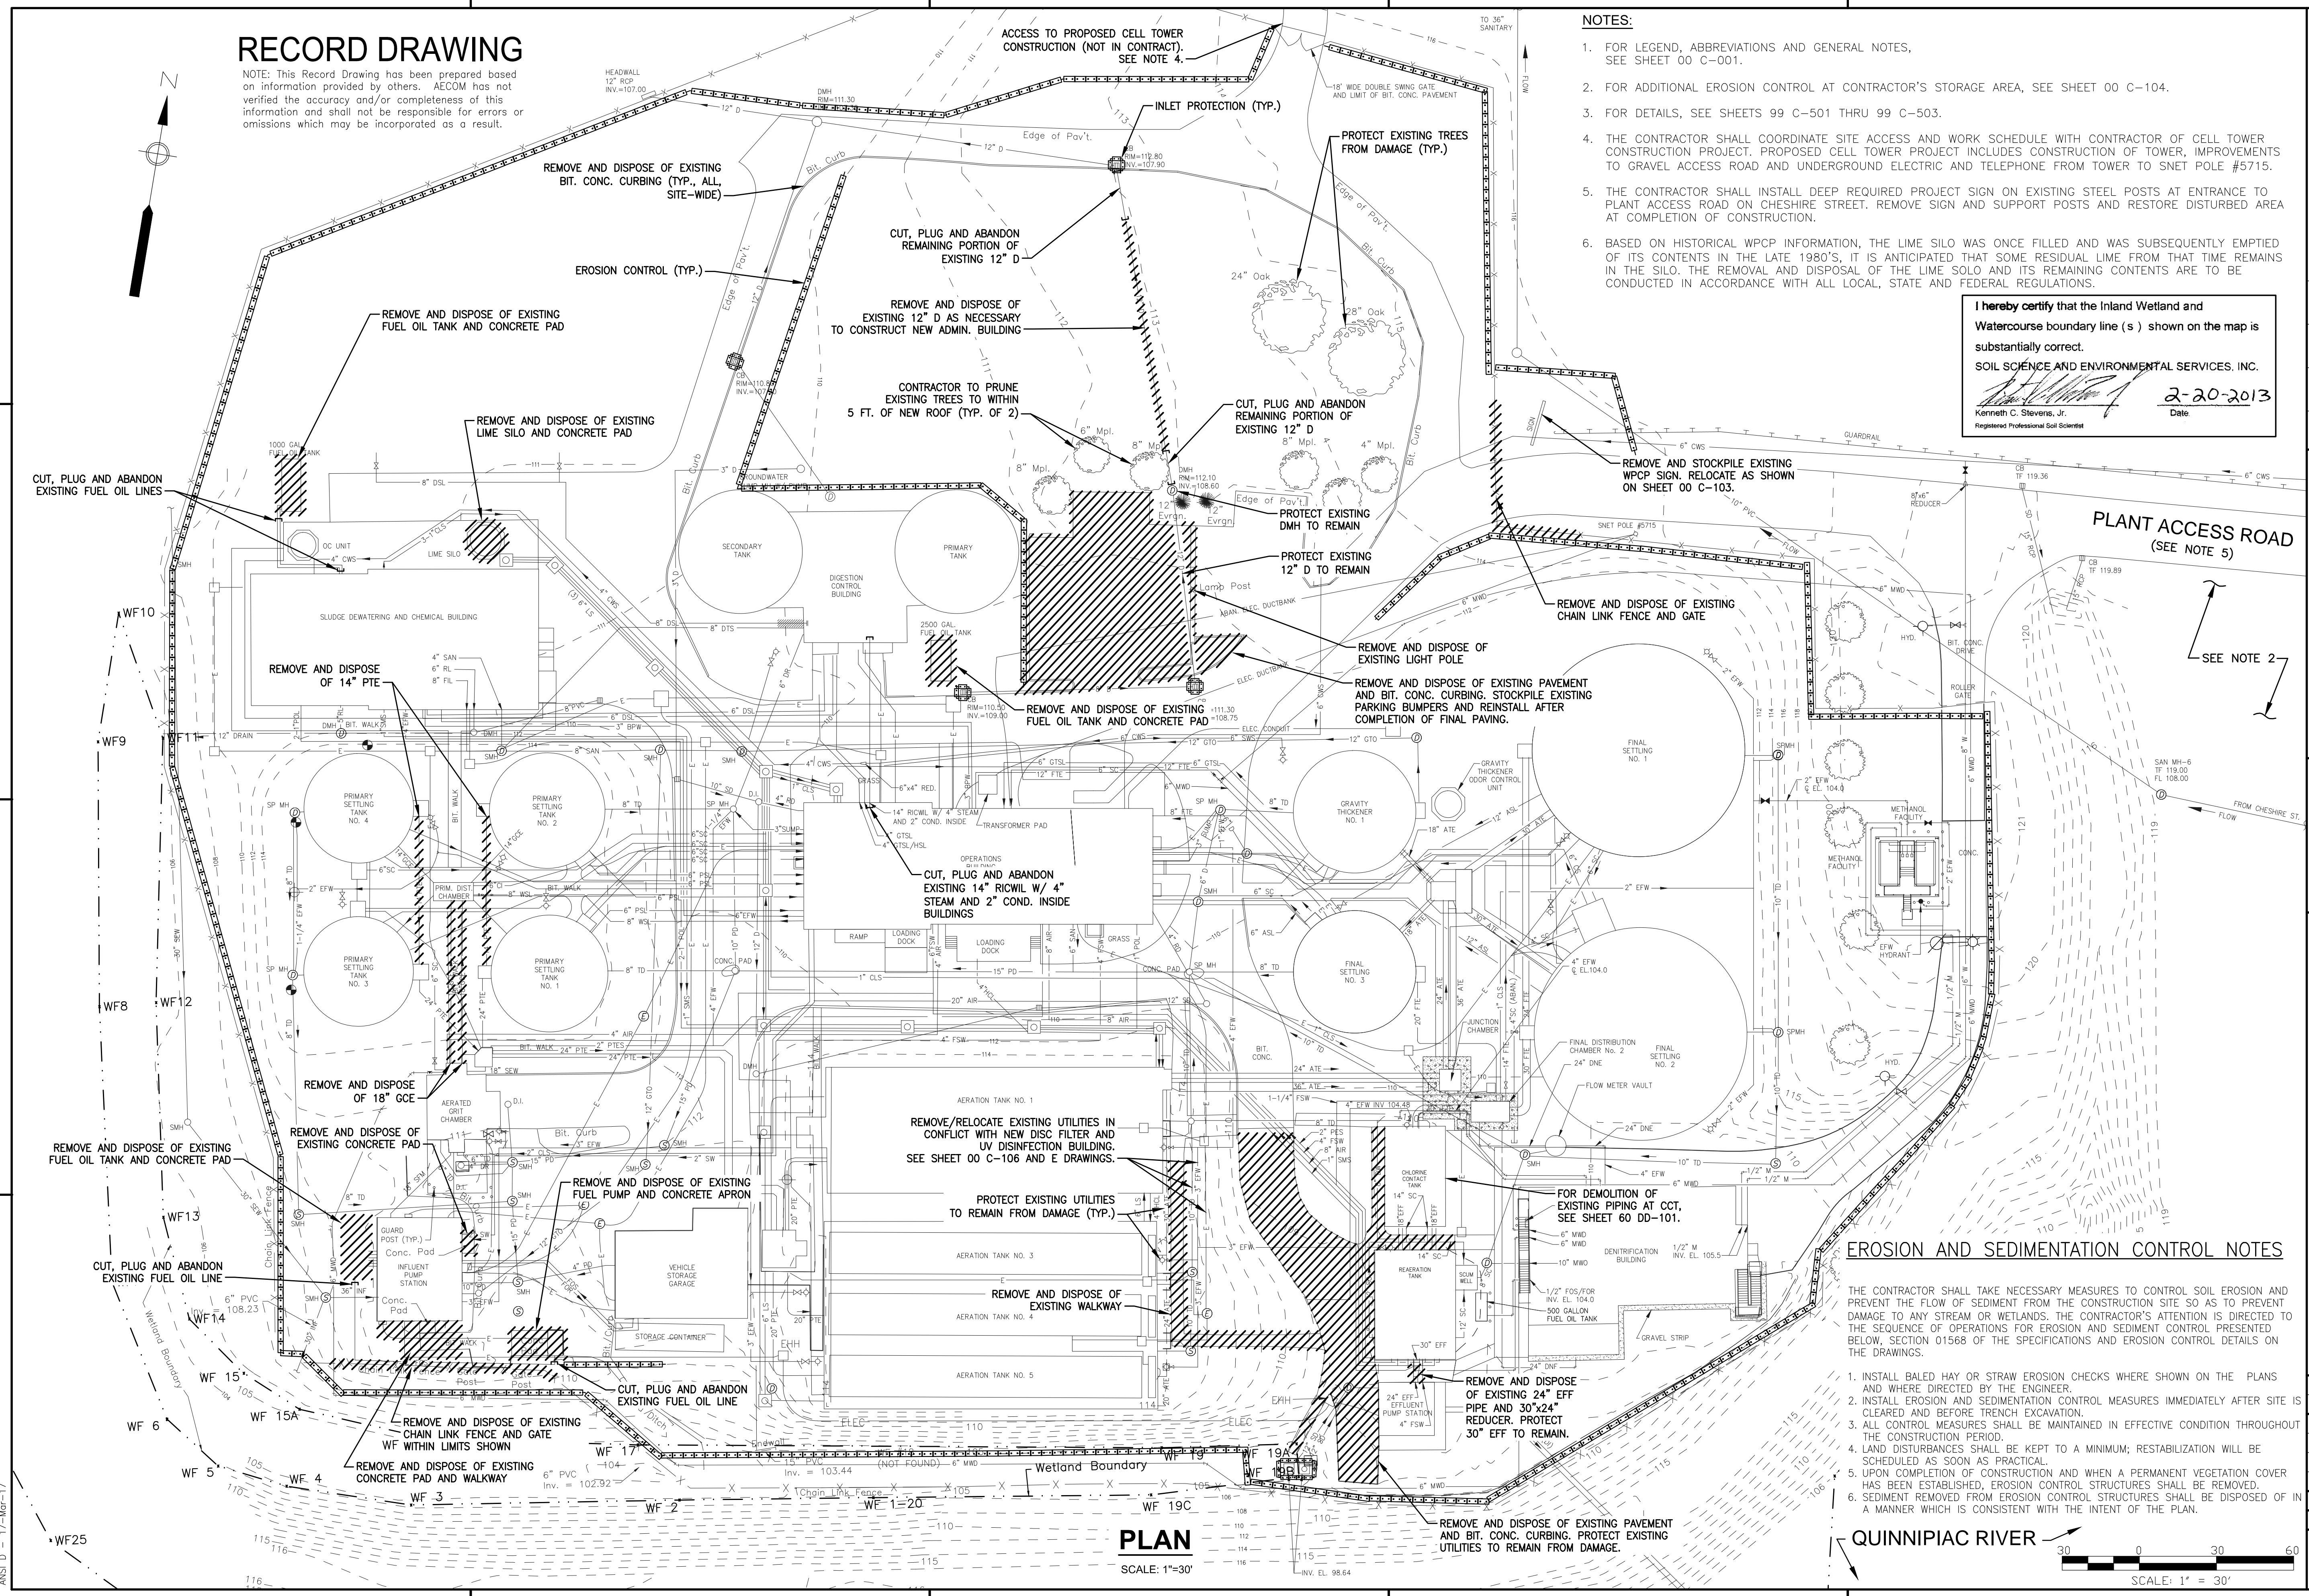

EROSION AND SEDIMENTATION CONTROL NOTES

- THE CONTRACTOR SHALL TAKE NECESSARY MEASURES TO CONTROL SOIL EROSION AND PREVENT THE FLOW OF SEDIMENT FROM THE CONSTRUCTION SITE SO AS TO PREVENT DAMAGE TO ANY STREAM OR WETLANDS. THE CONTRACTOR'S ATTENTION IS DIRECTED TO THE SEQUENCE OF OPERATIONS FOR EROSION AND SEDIMENT CONTROL PRESENTED BELOW. SECTION 01568 OF THE SPECIFICATIONS AND EROSION CONTROL DETAILS ON THE DRAWINGS.
- INSTALL BALED HAY OR STRAW EROSION CHECKS WHERE SHOWN ON THE PLANS AND WHERE DIRECTED BY THE ENGINEER.
 - INSTALL EROSION AND SEDIMENTATION CONTROL MEASURES IMMEDIATELY AFTER SITE IS CLEARED AND BEFORE TRENCH EXCAVATION.
 - ALL CONTROL MEASURES SHALL BE MAINTAINED IN EFFECTIVE CONDITION THROUGHOUT THE CONSTRUCTION PERIOD.
 - LAND DISTURBANCES SHALL BE KEPT TO A MINIMUM; RESTABILIZATION WILL BE SCHEDULED AS SOON AS PRACTICAL.
 - UPON COMPLETION OF CONSTRUCTION AND WHEN A PERMANENT VEGETATION COVER HAS BEEN ESTABLISHED, EROSION CONTROL STRUCTURES SHALL BE REMOVED.
 - SEDIMENT REMOVED FROM EROSION CONTROL STRUCTURES SHALL BE DISPOSED OF IN A MANNER WHICH IS CONSISTENT WITH THE INTENT OF THE PLAN.

PLAN
SCALE: 1"=30'

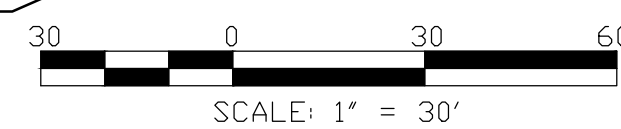

REVISIONS	
MARK	DESCRIPTION
1	5/5/17 BS MF
	DATE MADE BY CHECKED
	REVISOR FOR RECORD DRAWINGS

AECOM

TOWN OF CHESHIRE, CONNECTICUT
CHESHIRE WPCP UPGRADE


EXISTING CONDITIONS, DEMOLITION AND EROSION CONTROL PLAN

CIVIL

PROJECT NO: 60197025
 CAD DWG FILE: 00 C-101
 DESIGNED BY: J. TRAINOR
 DRAWN BY: S. NAPOLITANO
 DEPT CHECK: C. BENZIGER
 PROJ CHECK: M. FORMICA
 DATE: MAY 2013
 SCALE: AS NOTED

00 C-101
SHEET OF

PATH/FILENAME: P:\60197025 - CHESHIRE WPCP UPGRADE\SHEETS\C00 C-101.DWG
 LAST UPDATE: Friday, March 17, 2017 12:20:04 PM
 PLOT DATE: Tuesday, May 09, 2017 15:50 PM
 ANSI D - 17-Mar-17

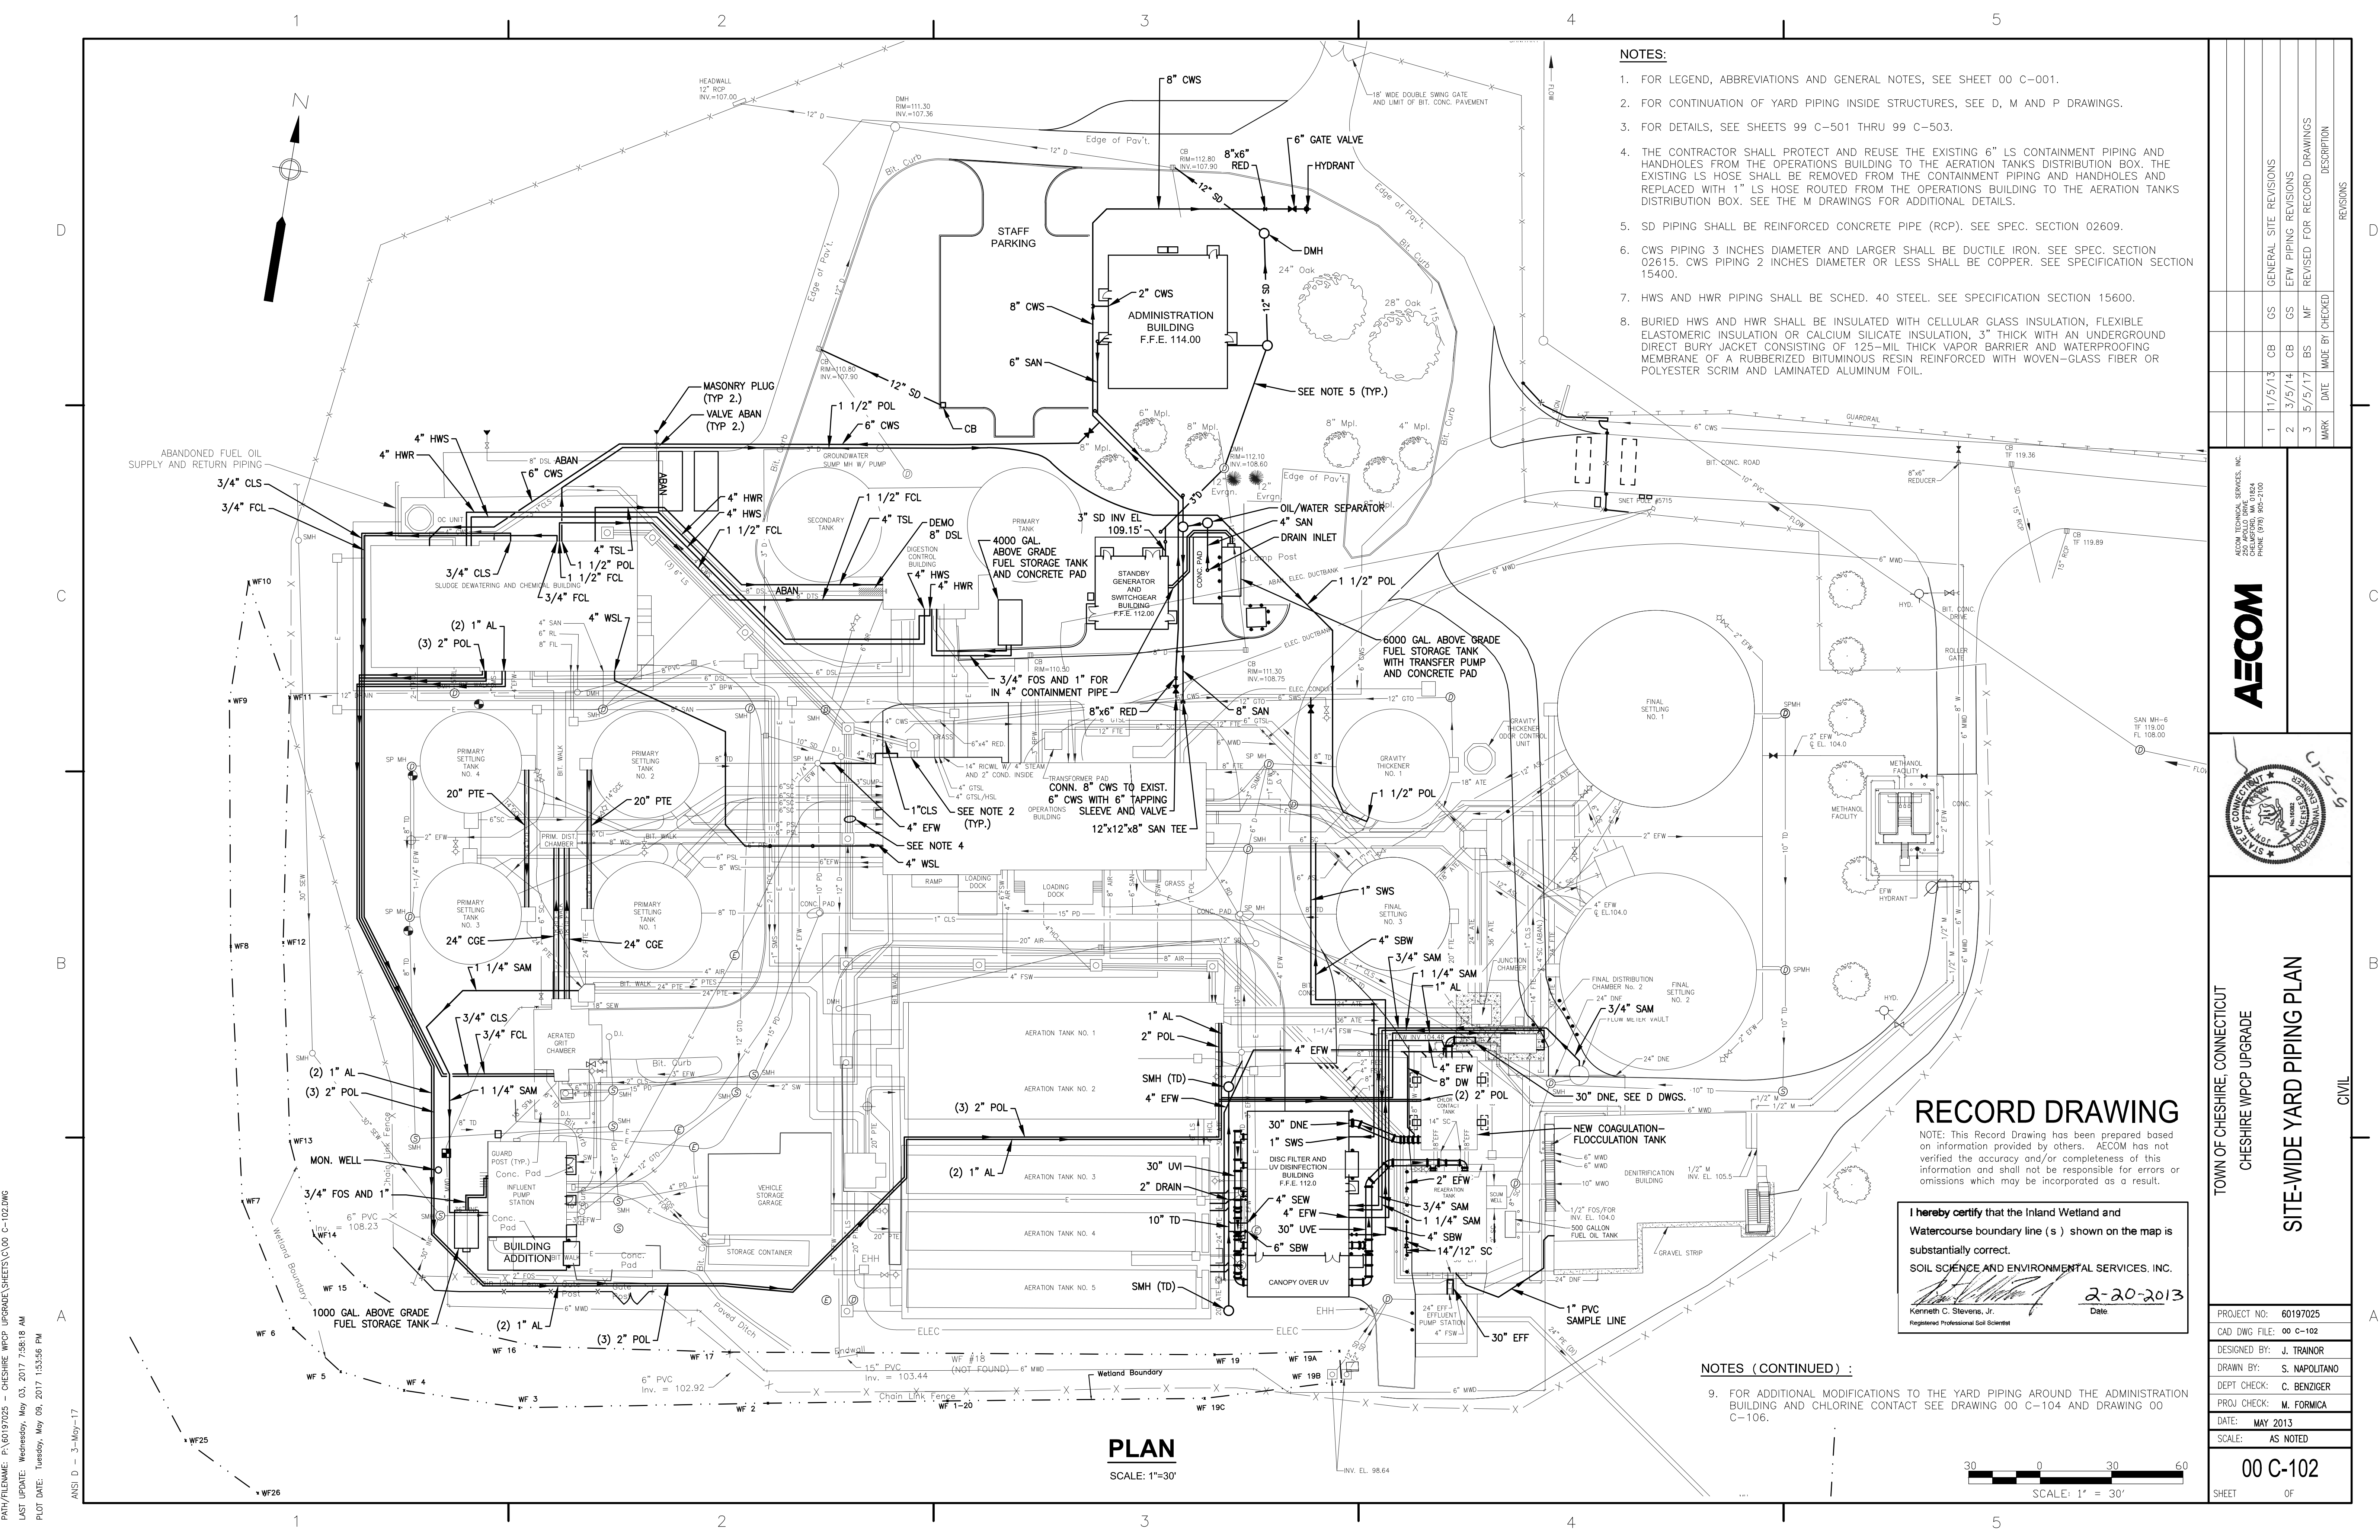

- NOTES:**
- FOR LEGEND, ABBREVIATIONS AND GENERAL NOTES, SEE SHEET 00 C-001.
 - FOR CONTINUATION OF YARD PIPING INSIDE STRUCTURES, SEE D, M AND P DRAWINGS.
 - FOR DETAILS, SEE SHEETS 99 C-501 THRU 99 C-503.
 - THE CONTRACTOR SHALL PROTECT AND REUSE THE EXISTING 6" LS CONTAINMENT PIPING AND HANDHOLES FROM THE OPERATIONS BUILDING TO THE AERATION TANKS DISTRIBUTION BOX. THE EXISTING LS HOSE SHALL BE REMOVED FROM THE CONTAINMENT PIPING AND HANDHOLES AND REPLACED WITH 1" LS HOSE ROUTED FROM THE OPERATIONS BUILDING TO THE AERATION TANKS DISTRIBUTION BOX. SEE THE M DRAWINGS FOR ADDITIONAL DETAILS.
 - SD PIPING SHALL BE REINFORCED CONCRETE PIPE (RCP). SEE SPEC. SECTION 02609.
 - CWS PIPING 3 INCHES DIAMETER AND LARGER SHALL BE DUCTILE IRON. SEE SPEC. SECTION 02615. CWS PIPING 2 INCHES DIAMETER OR LESS SHALL BE COPPER. SEE SPECIFICATION SECTION 15400.
 - HWS AND HWR PIPING SHALL BE SCHED. 40 STEEL. SEE SPECIFICATION SECTION 15600.
 - BURIED HWS AND HWR SHALL BE INSULATED WITH CELLULAR GLASS INSULATION, FLEXIBLE ELASTOMERIC INSULATION OR CALCIUM SILICATE INSULATION. 3" THICK WITH AN UNDERGROUND DIRECT BURY JACKET CONSISTING OF 125-MIL THICK VAPOR BARRIER AND WATERPROOFING MEMBRANE OF A RUBBERIZED BITUMINOUS RESIN REINFORCED WITH WOVEN-GLASS FIBER OR POLYESTER SCRIM AND LAMINATED ALUMINUM FOIL.


RECORD DRAWING

NOTE: This Record Drawing has been prepared based on information provided by others. AECOM has not verified the accuracy and/or completeness of this information and shall not be responsible for errors or omissions which may be incorporated as a result.

I hereby certify that the Inland Wetland and Watercourse boundary line (s) shown on the map is substantially correct.

SOIL SCIENCE AND ENVIRONMENTAL SERVICES, INC.
 Kenneth C. Stevens, Jr.
 Registered Professional Soil Scientist
 Date: 2-20-2013

- NOTES (CONTINUED):**
- FOR ADDITIONAL MODIFICATIONS TO THE YARD PIPING AROUND THE ADMINISTRATION BUILDING AND CHLORINE CONTACT SEE DRAWING 00 C-104 AND DRAWING 00 C-106.


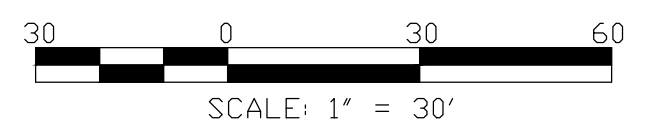


TOWN OF CHESHIRE, CONNECTICUT CHESHIRE WPCP UPGRADE SITE-WIDE YARD PIPING PLAN CIVIL	
PROJECT NO: 60197025 CAD DWG FILE: 00 C-102 DESIGNED BY: J. TRINOR DRAWN BY: S. NAPOLITANO DEPT CHECK: C. BENZIGER PROJECT CHECK: M. FORMICA DATE: MAY 2013 SCALE: AS NOTED	GENERAL SITE REVISIONS EFW PIPING REVISIONS REVISED FOR RECORD DRAWINGS MADE BY CHECKED DATE
SHEET 00 C-102 OF	

ANSI D - 3-May-17
 PATH/FILENAME: P:\60197025 - CHESHIRE WPCP UPGRADE\DWG\00 C-102.DWG
 LAST UPDATE: Wednesday, May 03, 2017 7:58:18 AM
 PLOT DATE: Tuesday, May 09, 2017 1:53:56 PM

ANSI D - 3-May-17

PATH/FILENAME: P:\60197025 - CHESHIRE WPCP UPGRADE\SHEETS\00 C-103.DWG
 LAST UPDATE: Wednesday, May 03, 2017 8:02:20 AM
 PLOT DATE: Tuesday, May 09, 2017 1:54:01 PM

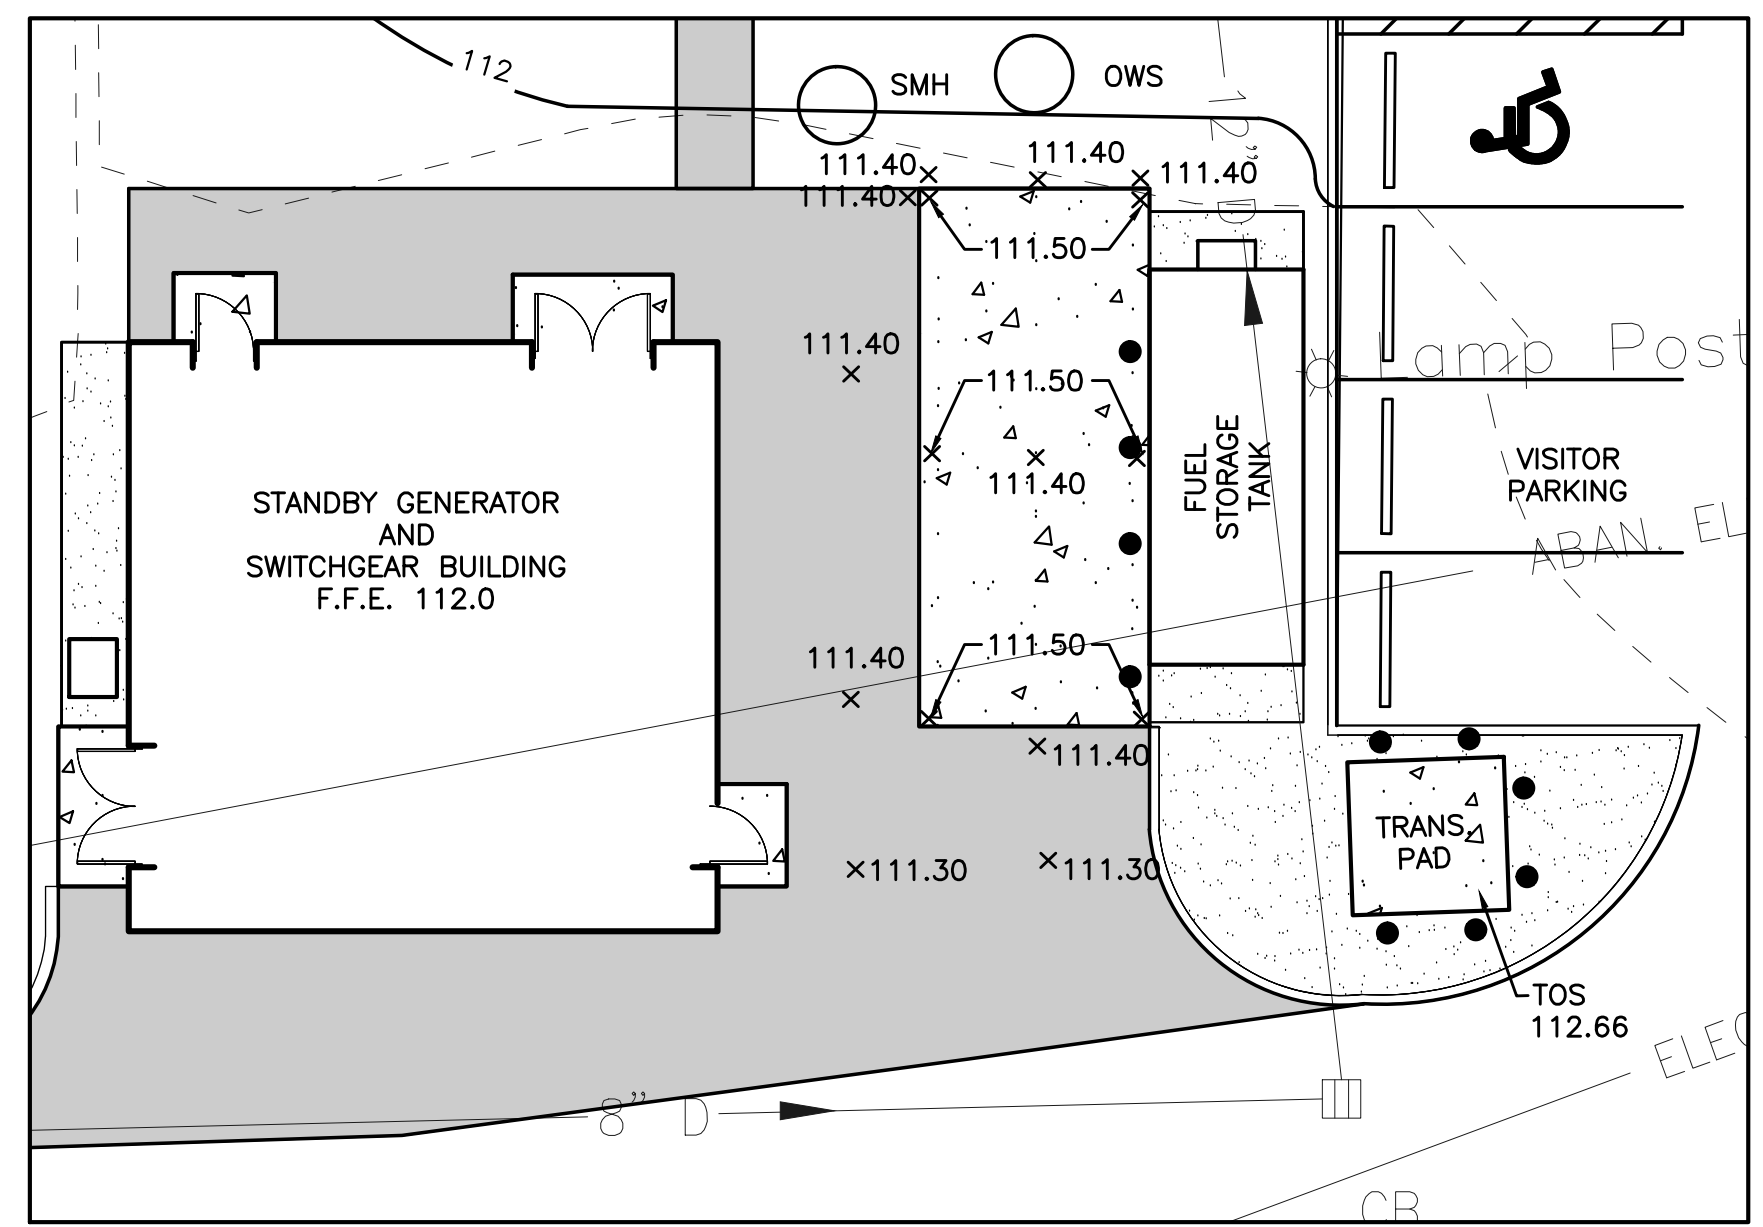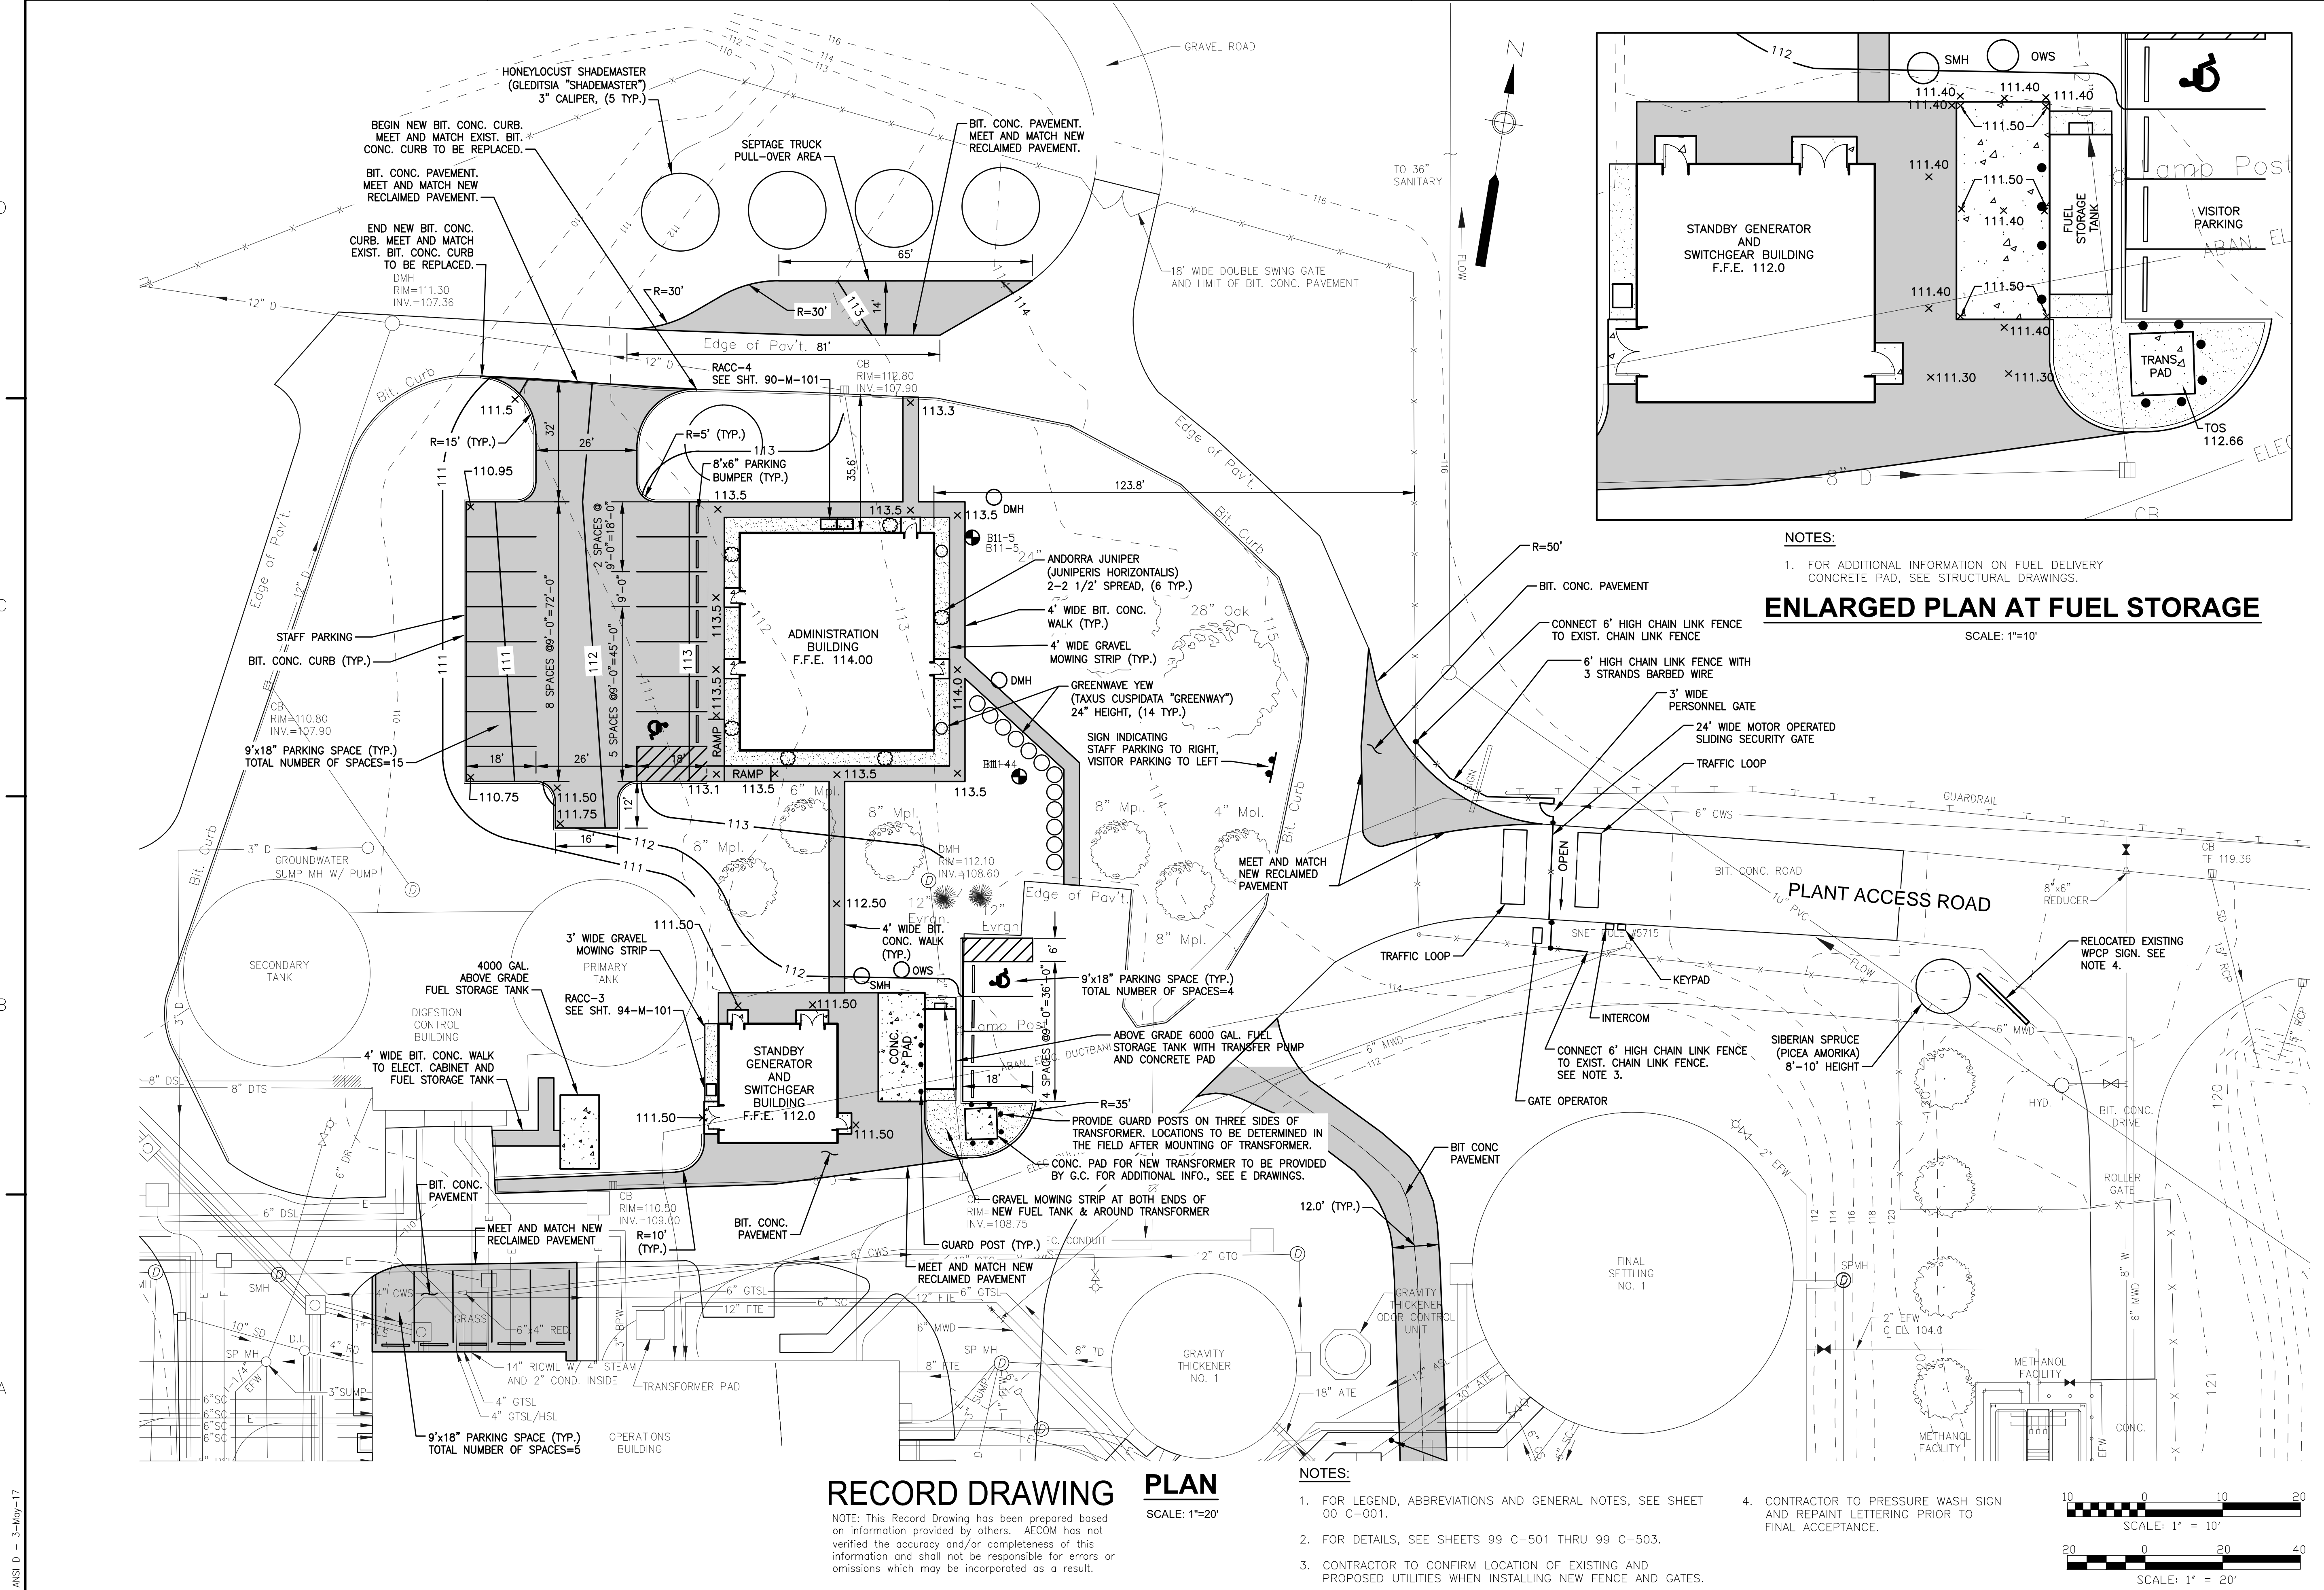

NOTES:
 1. FOR ADDITIONAL INFORMATION ON FUEL DELIVERY CONCRETE PAD, SEE STRUCTURAL DRAWINGS.

ENLARGED PLAN AT FUEL STORAGE

SCALE: 1"=10'


RECORD DRAWING PLAN

NOTE: This Record Drawing has been prepared based on information provided by others. AECOM has not verified the accuracy and/or completeness of this information and shall not be responsible for errors or omissions which may be incorporated as a result.

SCALE: 1"=20'



NOTES:

1. FOR LEGEND, ABBREVIATIONS AND GENERAL NOTES, SEE SHEET 00 C-001.
2. FOR DETAILS, SEE SHEETS 99 C-501 THRU 99 C-503.
3. CONTRACTOR TO CONFIRM LOCATION OF EXISTING AND PROPOSED UTILITIES WHEN INSTALLING NEW FENCE AND GATES.
4. CONTRACTOR TO PRESSURE WASH SIGN AND REPAINT LETTERING PRIOR TO FINAL ACCEPTANCE.

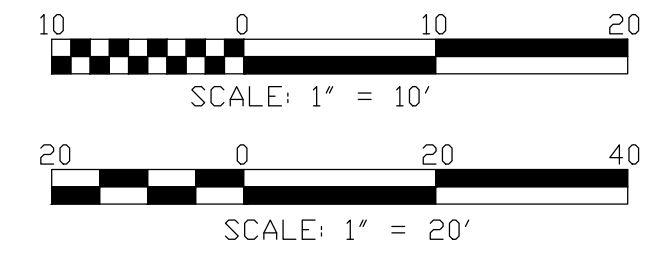

<p>REVISIONS</p> <table border="1"> <tr> <th>MARK</th> <th>DATE</th> <th>MADE BY</th> <th>CHECKED</th> <th>DESCRIPTION</th> </tr> <tr> <td>1</td> <td>11/17/13</td> <td>CB</td> <td>GS</td> <td>REVISED FOR RFI 009 AND RFI 012.</td> </tr> <tr> <td>2</td> <td>12/9/13</td> <td>CB</td> <td>GS</td> <td>REVISED FOR GEN./SWITCHGR. BLDG. ROTATED</td> </tr> <tr> <td>3</td> <td>5/5/17</td> <td>BS</td> <td>MF</td> <td>REVISED FOR RECORD DRAWINGS</td> </tr> </table>		MARK	DATE	MADE BY	CHECKED	DESCRIPTION	1	11/17/13	CB	GS	REVISED FOR RFI 009 AND RFI 012.	2	12/9/13	CB	GS	REVISED FOR GEN./SWITCHGR. BLDG. ROTATED	3	5/5/17	BS	MF	REVISED FOR RECORD DRAWINGS
MARK	DATE	MADE BY	CHECKED	DESCRIPTION																	
1	11/17/13	CB	GS	REVISED FOR RFI 009 AND RFI 012.																	
2	12/9/13	CB	GS	REVISED FOR GEN./SWITCHGR. BLDG. ROTATED																	
3	5/5/17	BS	MF	REVISED FOR RECORD DRAWINGS																	
<p>AECOM TECHNICAL SERVICES, INC. 200 WEST 10TH AVENUE, SUITE 1000 DENVER, COLORADO 80202, USA PHONE (970) 905-2100</p> <p>AECOM</p>																					
<p>TOWN OF CHESHIRE, CONNECTICUT CHESHIRE WPCP UPGRADE ENLARGED PLAN I - ADMINISTRATION BUILDING - SITE LAYOUT PLAN CIVIL</p>																					
<p>PROJECT NO: 60197025 CAD DWG FILE: 00 C-103 DESIGNED BY: J. TRAINOR DRAWN BY: S. NAPOLITANO DEPT CHECK: C. BENZIGER PROJ CHECK: M. FORMICA DATE: MAY 2013 SCALE: AS NOTED</p>																					
<p>00 C-103 SHEET OF</p>																					

PATH/FILENAME: P:\60197025 - CHESHIRE WPCP UPGRADE\SHEETS\C00 C-104.DWG
 LAST UPDATE: Wednesday, May 03, 2017 8:03:30 AM
 PLOT DATE: Tuesday, May 09, 2017 15:40:06 PM
 ANSL D - 3-May-17

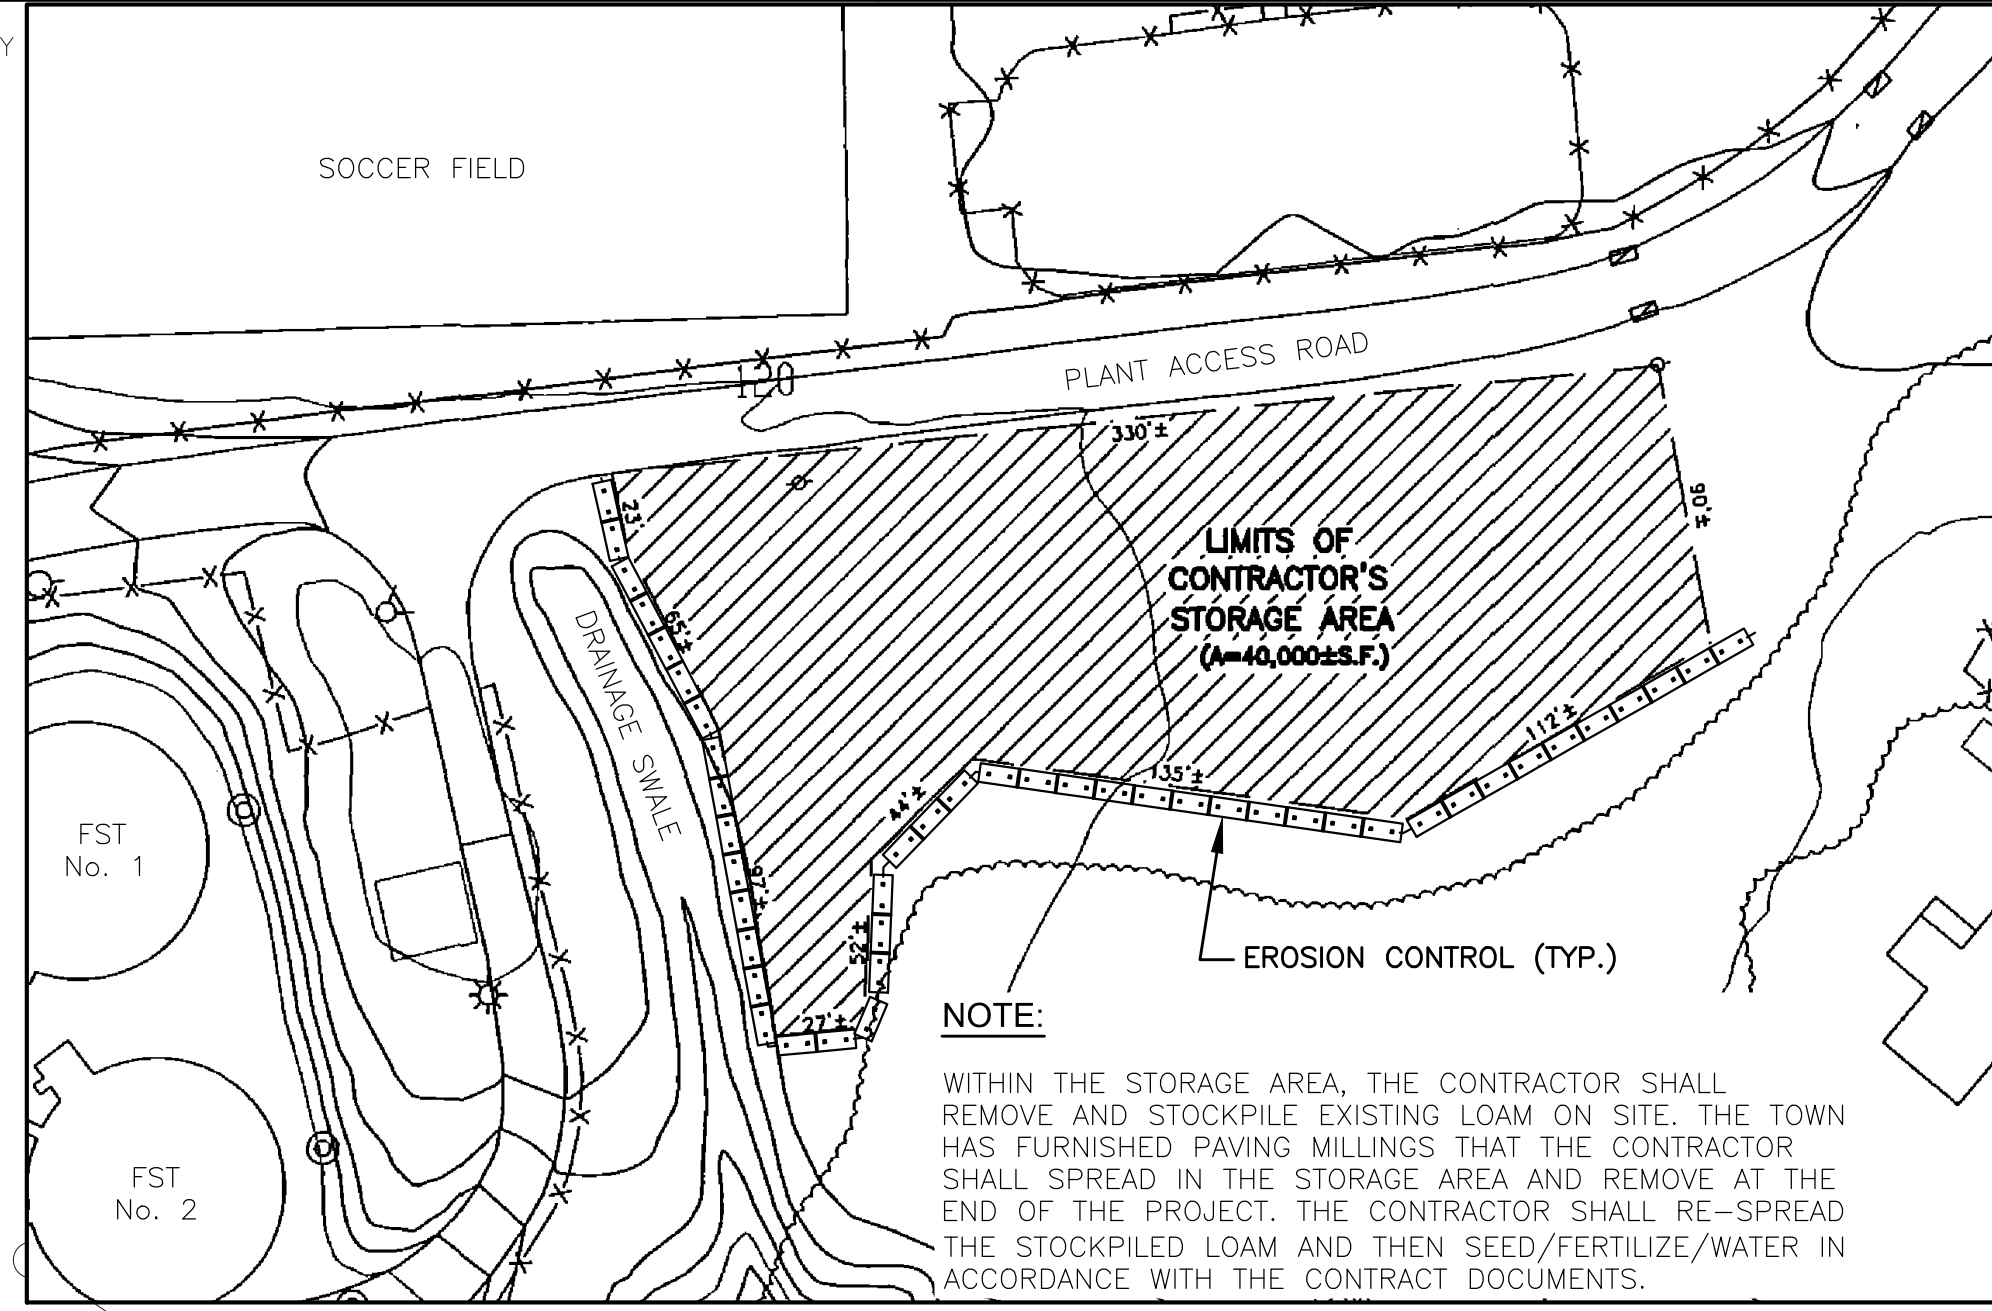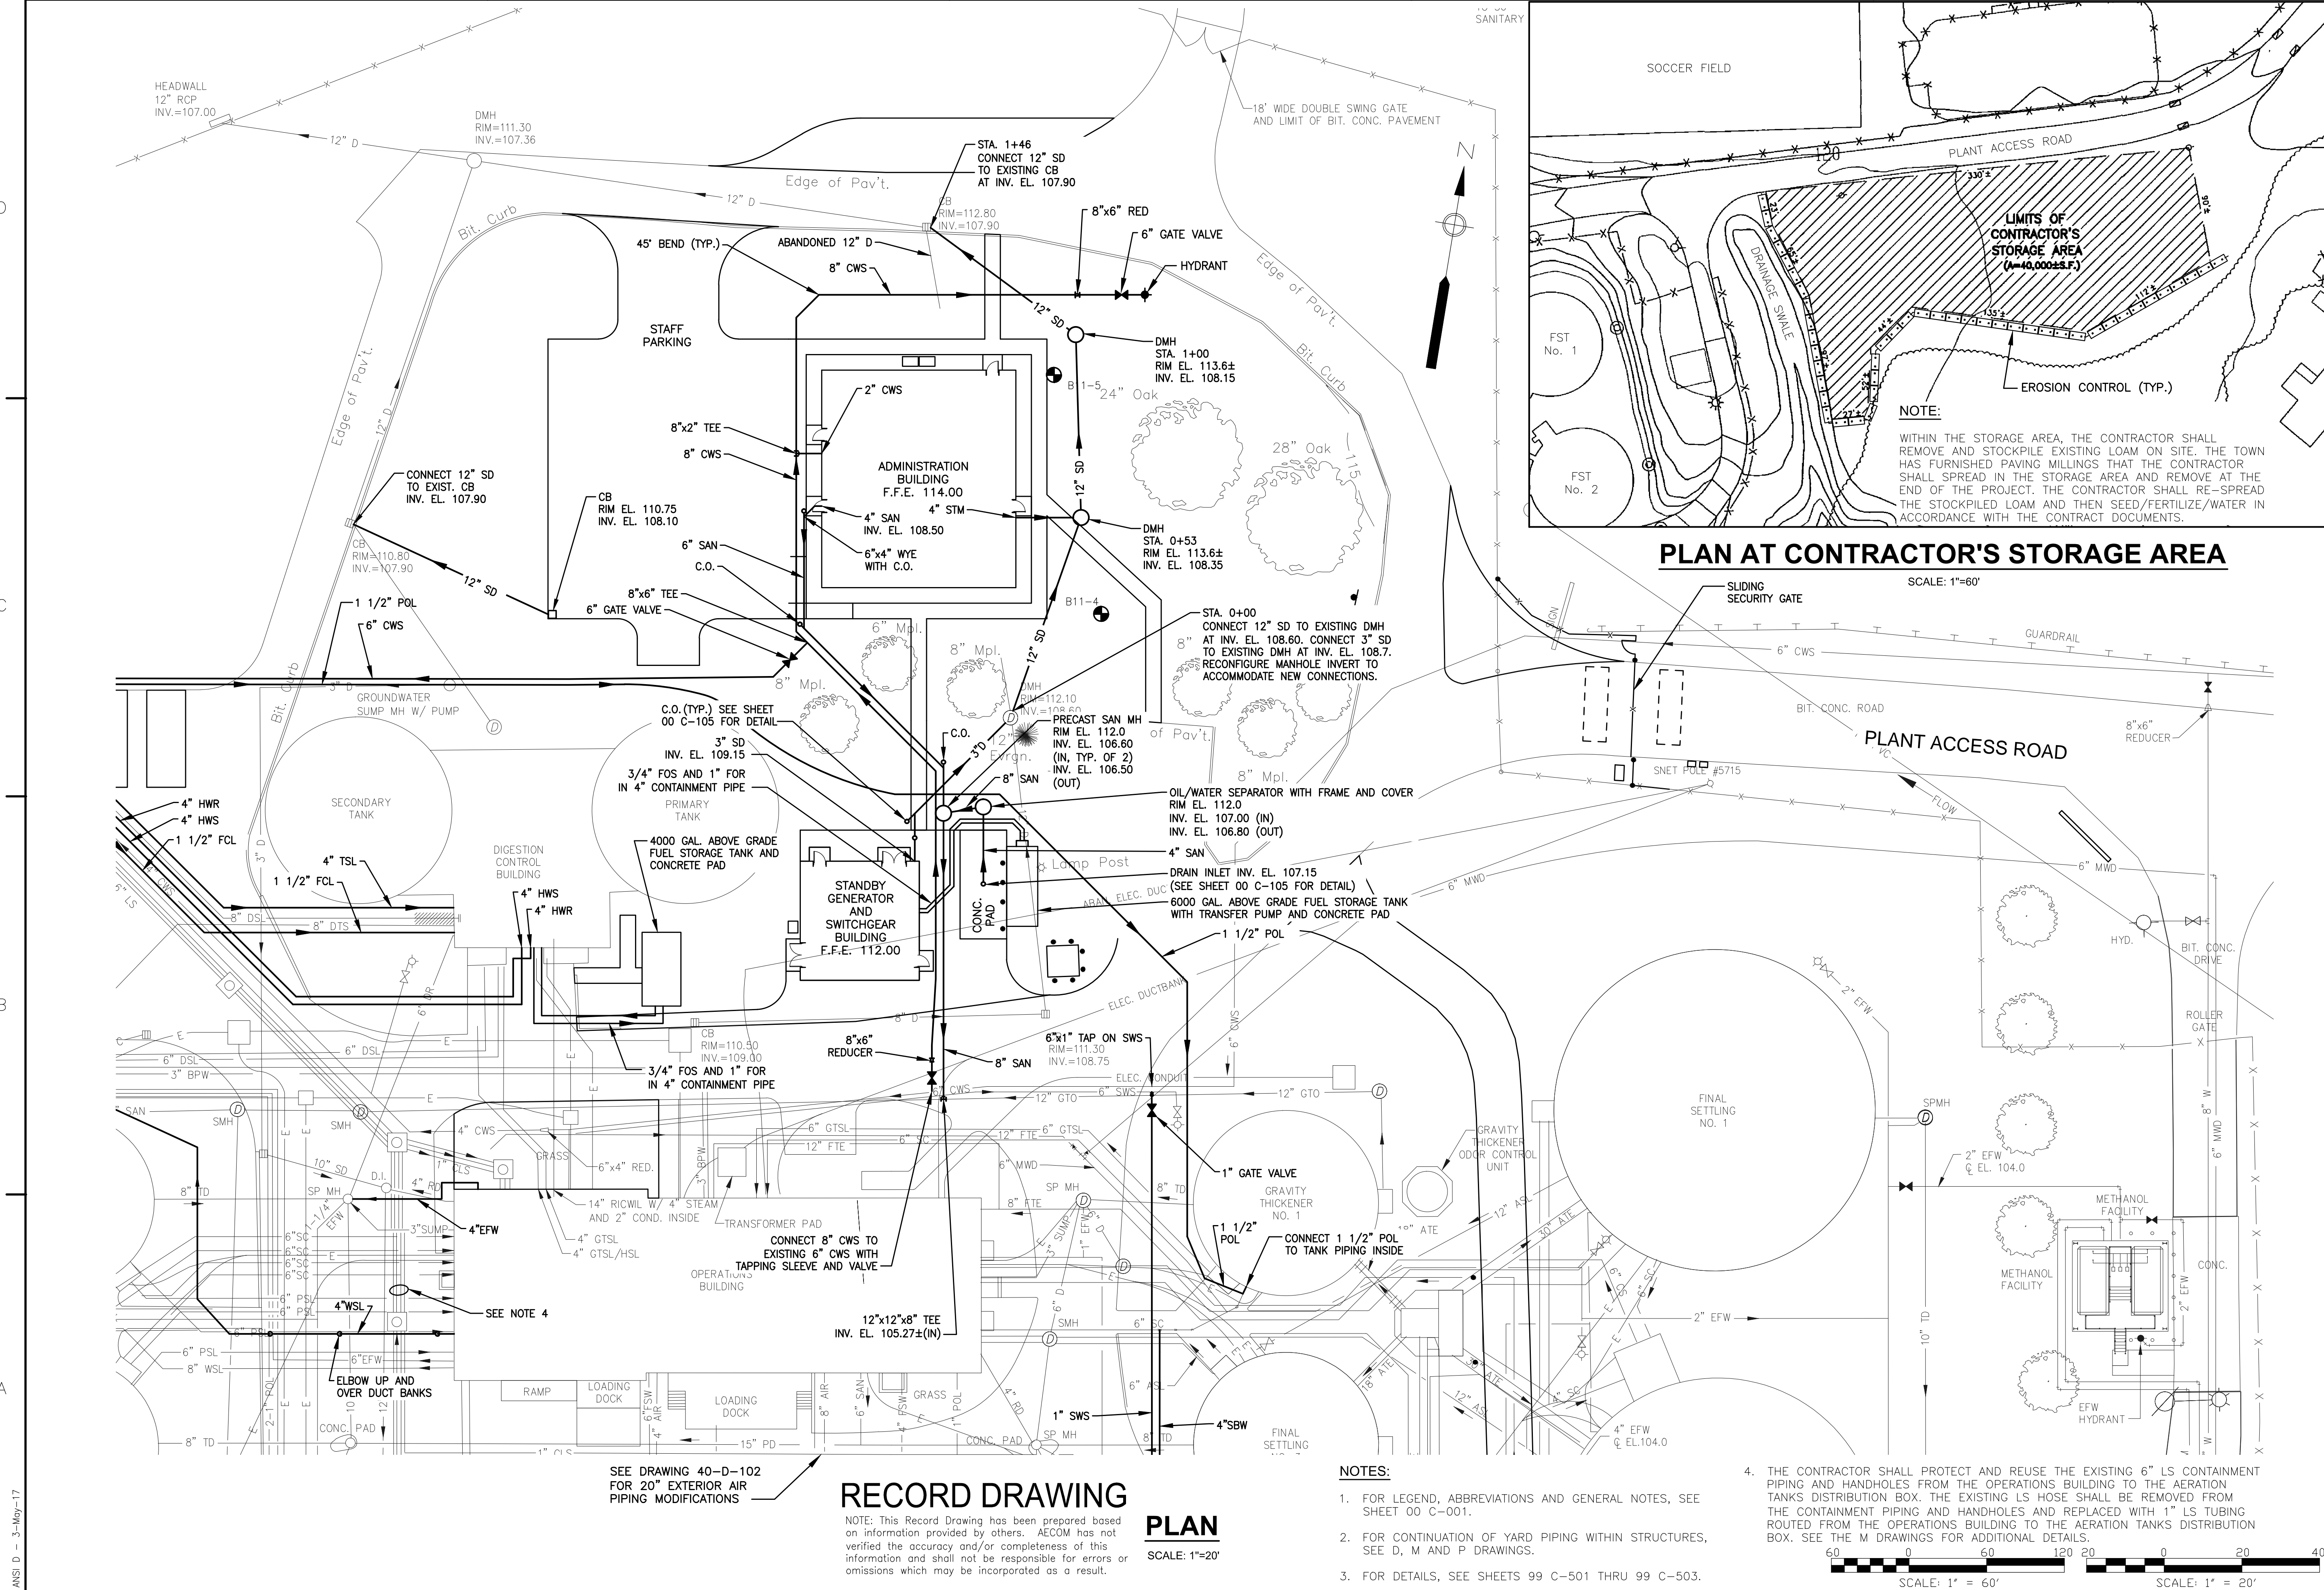

RECORD DRAWING

NOTE: This Record Drawing has been prepared based on information provided by others. AECOM has not verified the accuracy and/or completeness of this information and shall not be responsible for errors or omissions which may be incorporated as a result.


PLAN

SCALE: 1"=20'

NOTES:

- FOR LEGEND, ABBREVIATIONS AND GENERAL NOTES, SEE SHEET 00 C-001.
- FOR CONTINUATION OF YARD PIPING WITHIN STRUCTURES, SEE D, M AND P DRAWINGS.
- FOR DETAILS, SEE SHEETS 99 C-501 THRU 99 C-503.

- THE CONTRACTOR SHALL PROTECT AND REUSE THE EXISTING 6" LS CONTAINMENT PIPING AND HANDHOLES FROM THE OPERATIONS BUILDING TO THE AERATION TANKS DISTRIBUTION BOX. THE EXISTING LS HOSE SHALL BE REMOVED FROM THE CONTAINMENT PIPING AND HANDHOLES AND REPLACED WITH 1" LS TUBING ROUTED FROM THE OPERATIONS BUILDING TO THE AERATION TANKS DISTRIBUTION BOX. SEE THE M DRAWINGS FOR ADDITIONAL DETAILS.

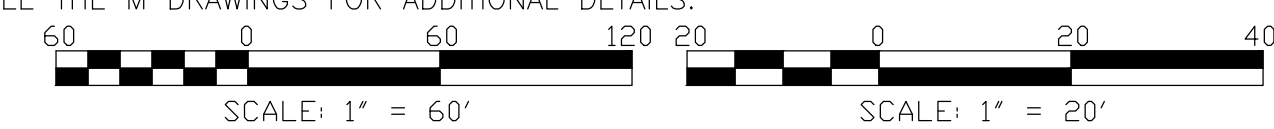

REVISIONS	
MARK	DATE
1	12/9/13
2	12/23/13
3	5/5/17


PROJECT NO: 60197025
 CAD DWG FILE: 00 C-104
 DESIGNED BY: J. TRAINOR
 DRAWN BY: S. NAPOLITANO
 DEPT CHECK: C. BENZIGER
 PROJ CHECK: M. FORMICA
 DATE: MAY 2013
 SCALE: AS NOTED
00 C-104
 SHEET OF

AECOM TECHNICAL SERVICES, INC.
 200 WASHINGTON ST., SUITE 200
 BOSTON, MA 02108
 PHONE (978) 405-1100


AECOM

TOWN OF CHESHIRE, CONNECTICUT
 CHESHIRE WPCP UPGRADE
ENLARGED PLAN II -
ADMINISTRATION BUILDING -
YARD PIPING PLAN
 CIVIL


PATH/FILENAME: P:\60197025 - CHESHIRE WPCP UPGRADE\SHEETS\00 C-105.DWG
 LAST UPDATE: Tuesday, May 09, 2017 12:38:20 PM
 PLOT DATE: Tuesday, May 09, 2017 1:54:11 PM
 ANS I D - 9-May-17

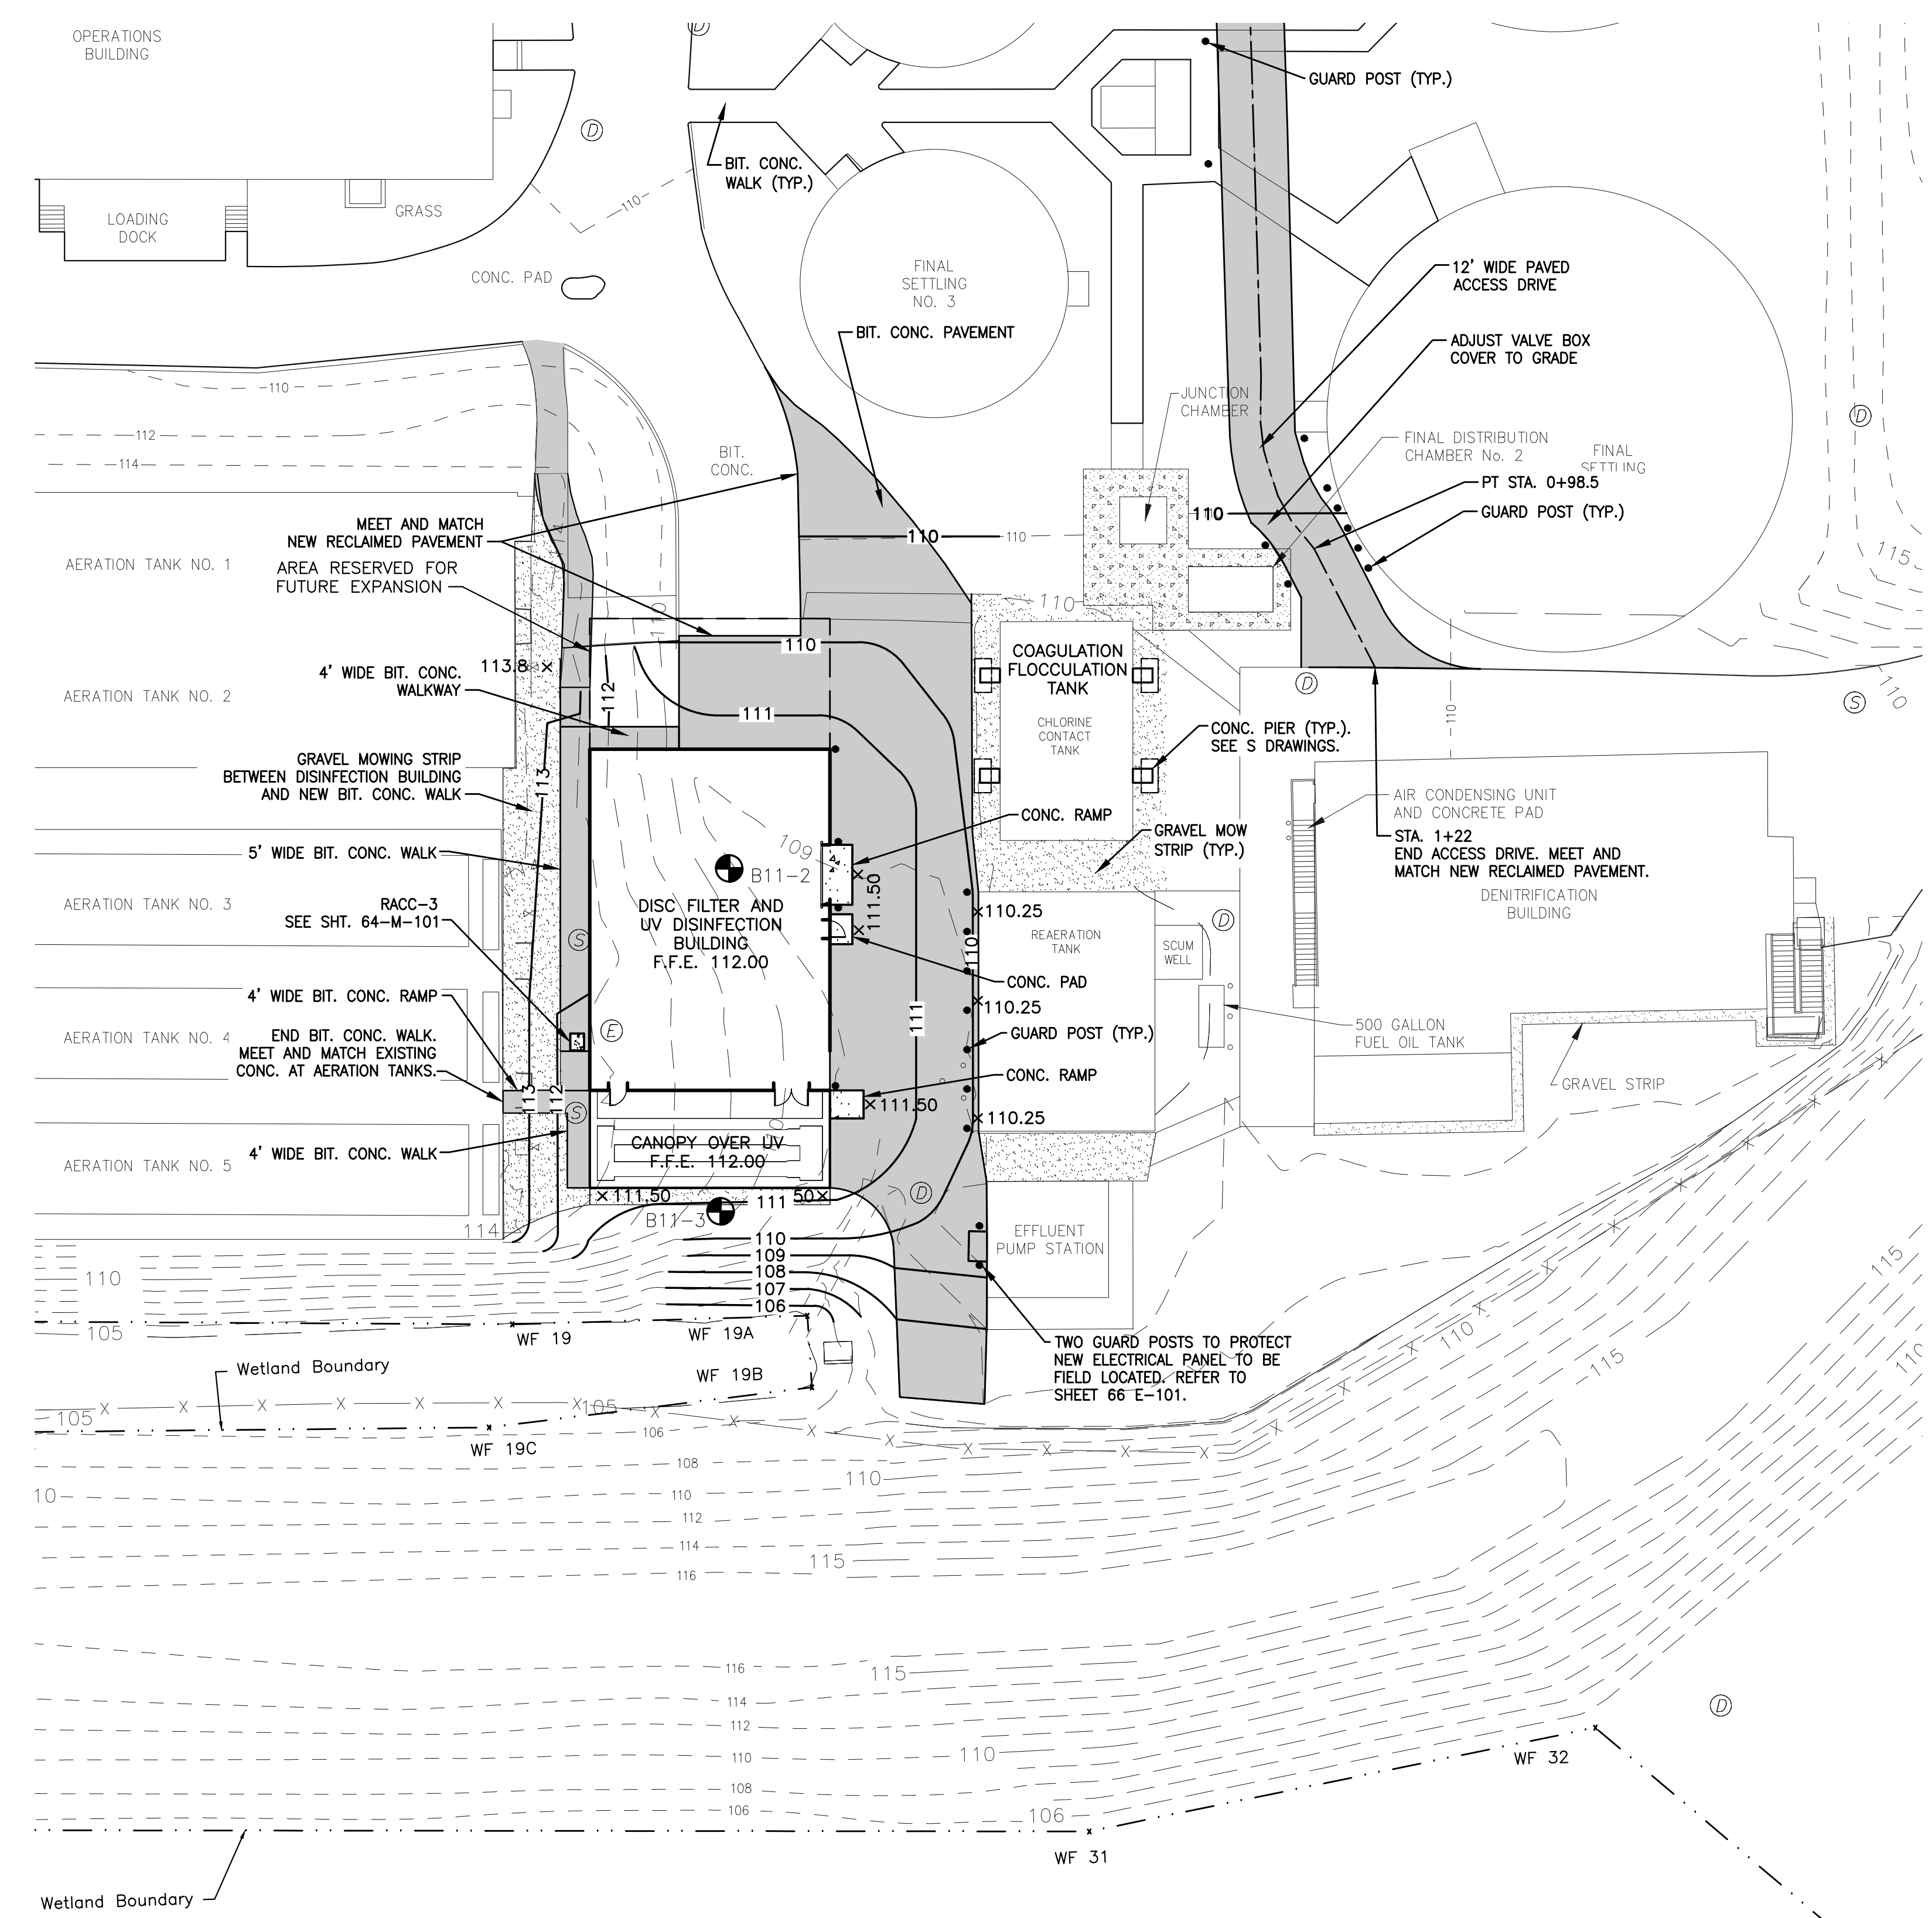

I hereby certify that the Inland Wetland and Watercourse boundary line (s) shown on the map is substantially correct.
 SOIL SCIENCE AND ENVIRONMENTAL SERVICES, INC.
 Kenneth C. Stevens, Jr.
 Registered Professional Soil Scientist
 Date: 2-20-2013

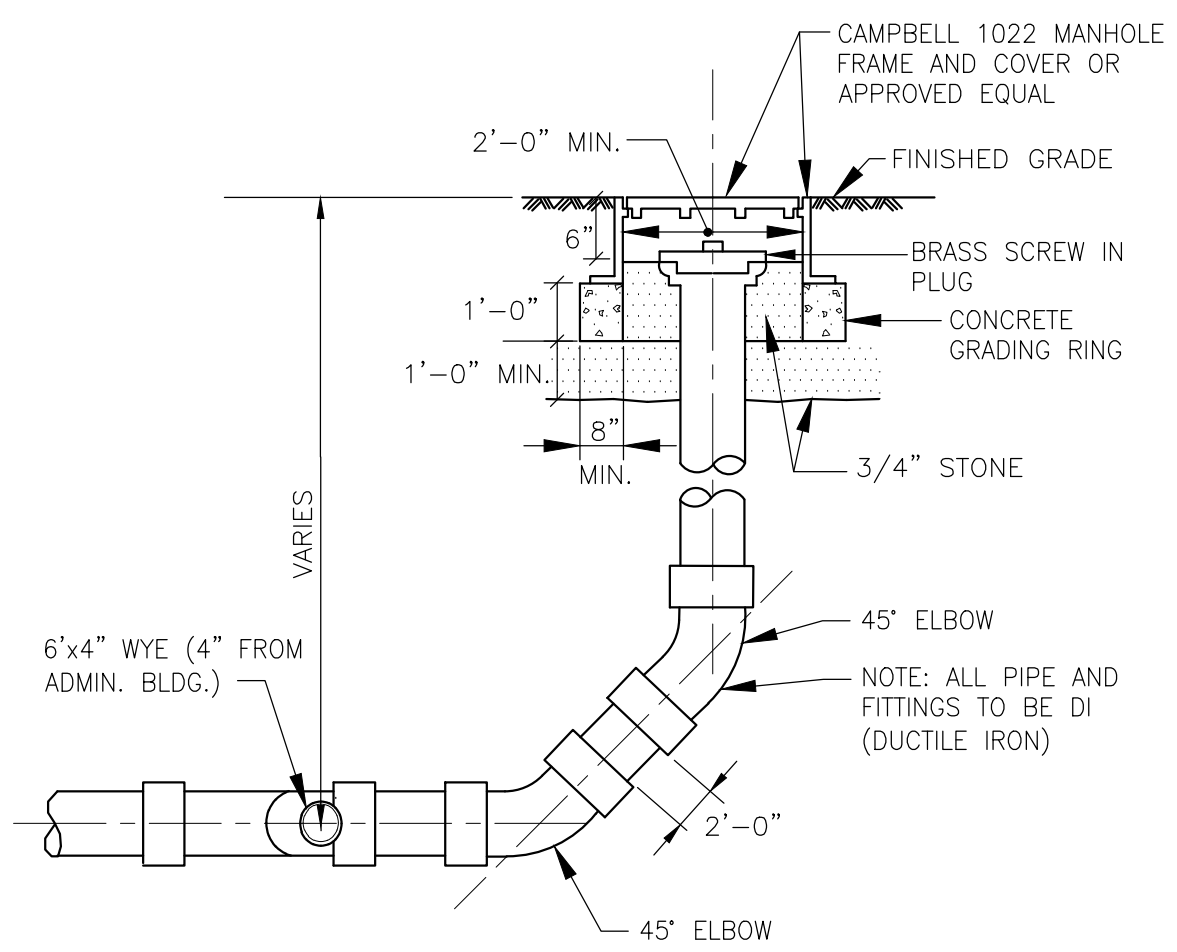


NOTE: FOR LOCATION OF CLEANOUT, SEE SHEET 00 C-104

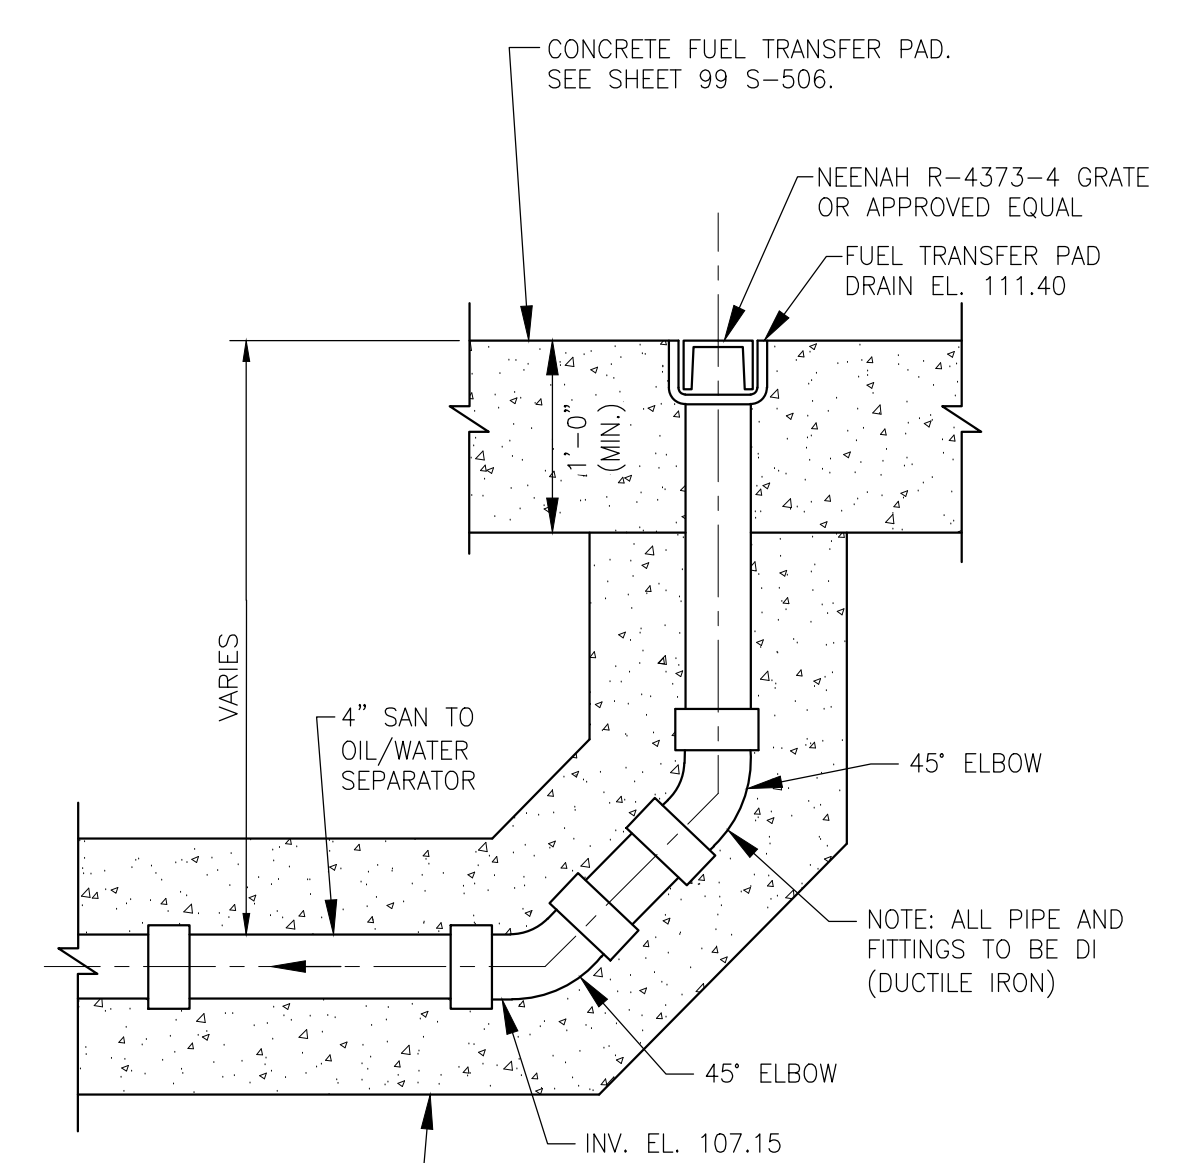

NOTE: FOR LOCATION OF DRAIN INLET, SEE SHEET 00 C-104

- NOTES:**
- FOR LEGEND, ABBREVIATIONS AND GENERAL NOTES, SEE SHEET 00 C-001.
 - FOR DETAILS, SEE SHEETS 99 C-501 THRU 99 C-503.

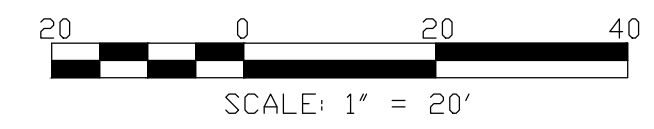

REVISIONS	
MARK	DESCRIPTION
1	11/5/13 CB
2	5/5/17 BS


PROJECT NO:	60197025
CAD DWG FILE:	00 C-105
DESIGNED BY:	J. TRAINOR
DRAWN BY:	S. NAPOLITANO
DEPT CHECK:	C. BENZIGER
PROJ CHECK:	M. FORMICA
DATE:	MAY 2013
SCALE:	AS NOTED
00 C-105	
SHEET OF	

TOWN OF CHESHIRE, CONNECTICUT
 CHESHIRE WPCP UPGRADE
ENLARGED PLAN III - DISC. FILT. & UV DIS. BLD. - SITE LAYOUT PLAN
 CIVIL



AECOM
 AECOM TECHNICAL SERVICES, INC.
 200 WEST WASHINGTON STREET, SUITE 200
 CHESHIRE, CONNECTICUT 06824
 PHONE (978) 805-2100


PATH/FILENAME: P:\60197025 - CHESHIRE WPCP UPGRADE\SHEETS\C00 C-106.DWG
 LAST UPDATE: Wednesday, May 03, 2017 8:05:53 AM
 PLOT DATE: Tuesday, May 09, 2017 1:54:15 PM
 ANSI D - 3-May-17

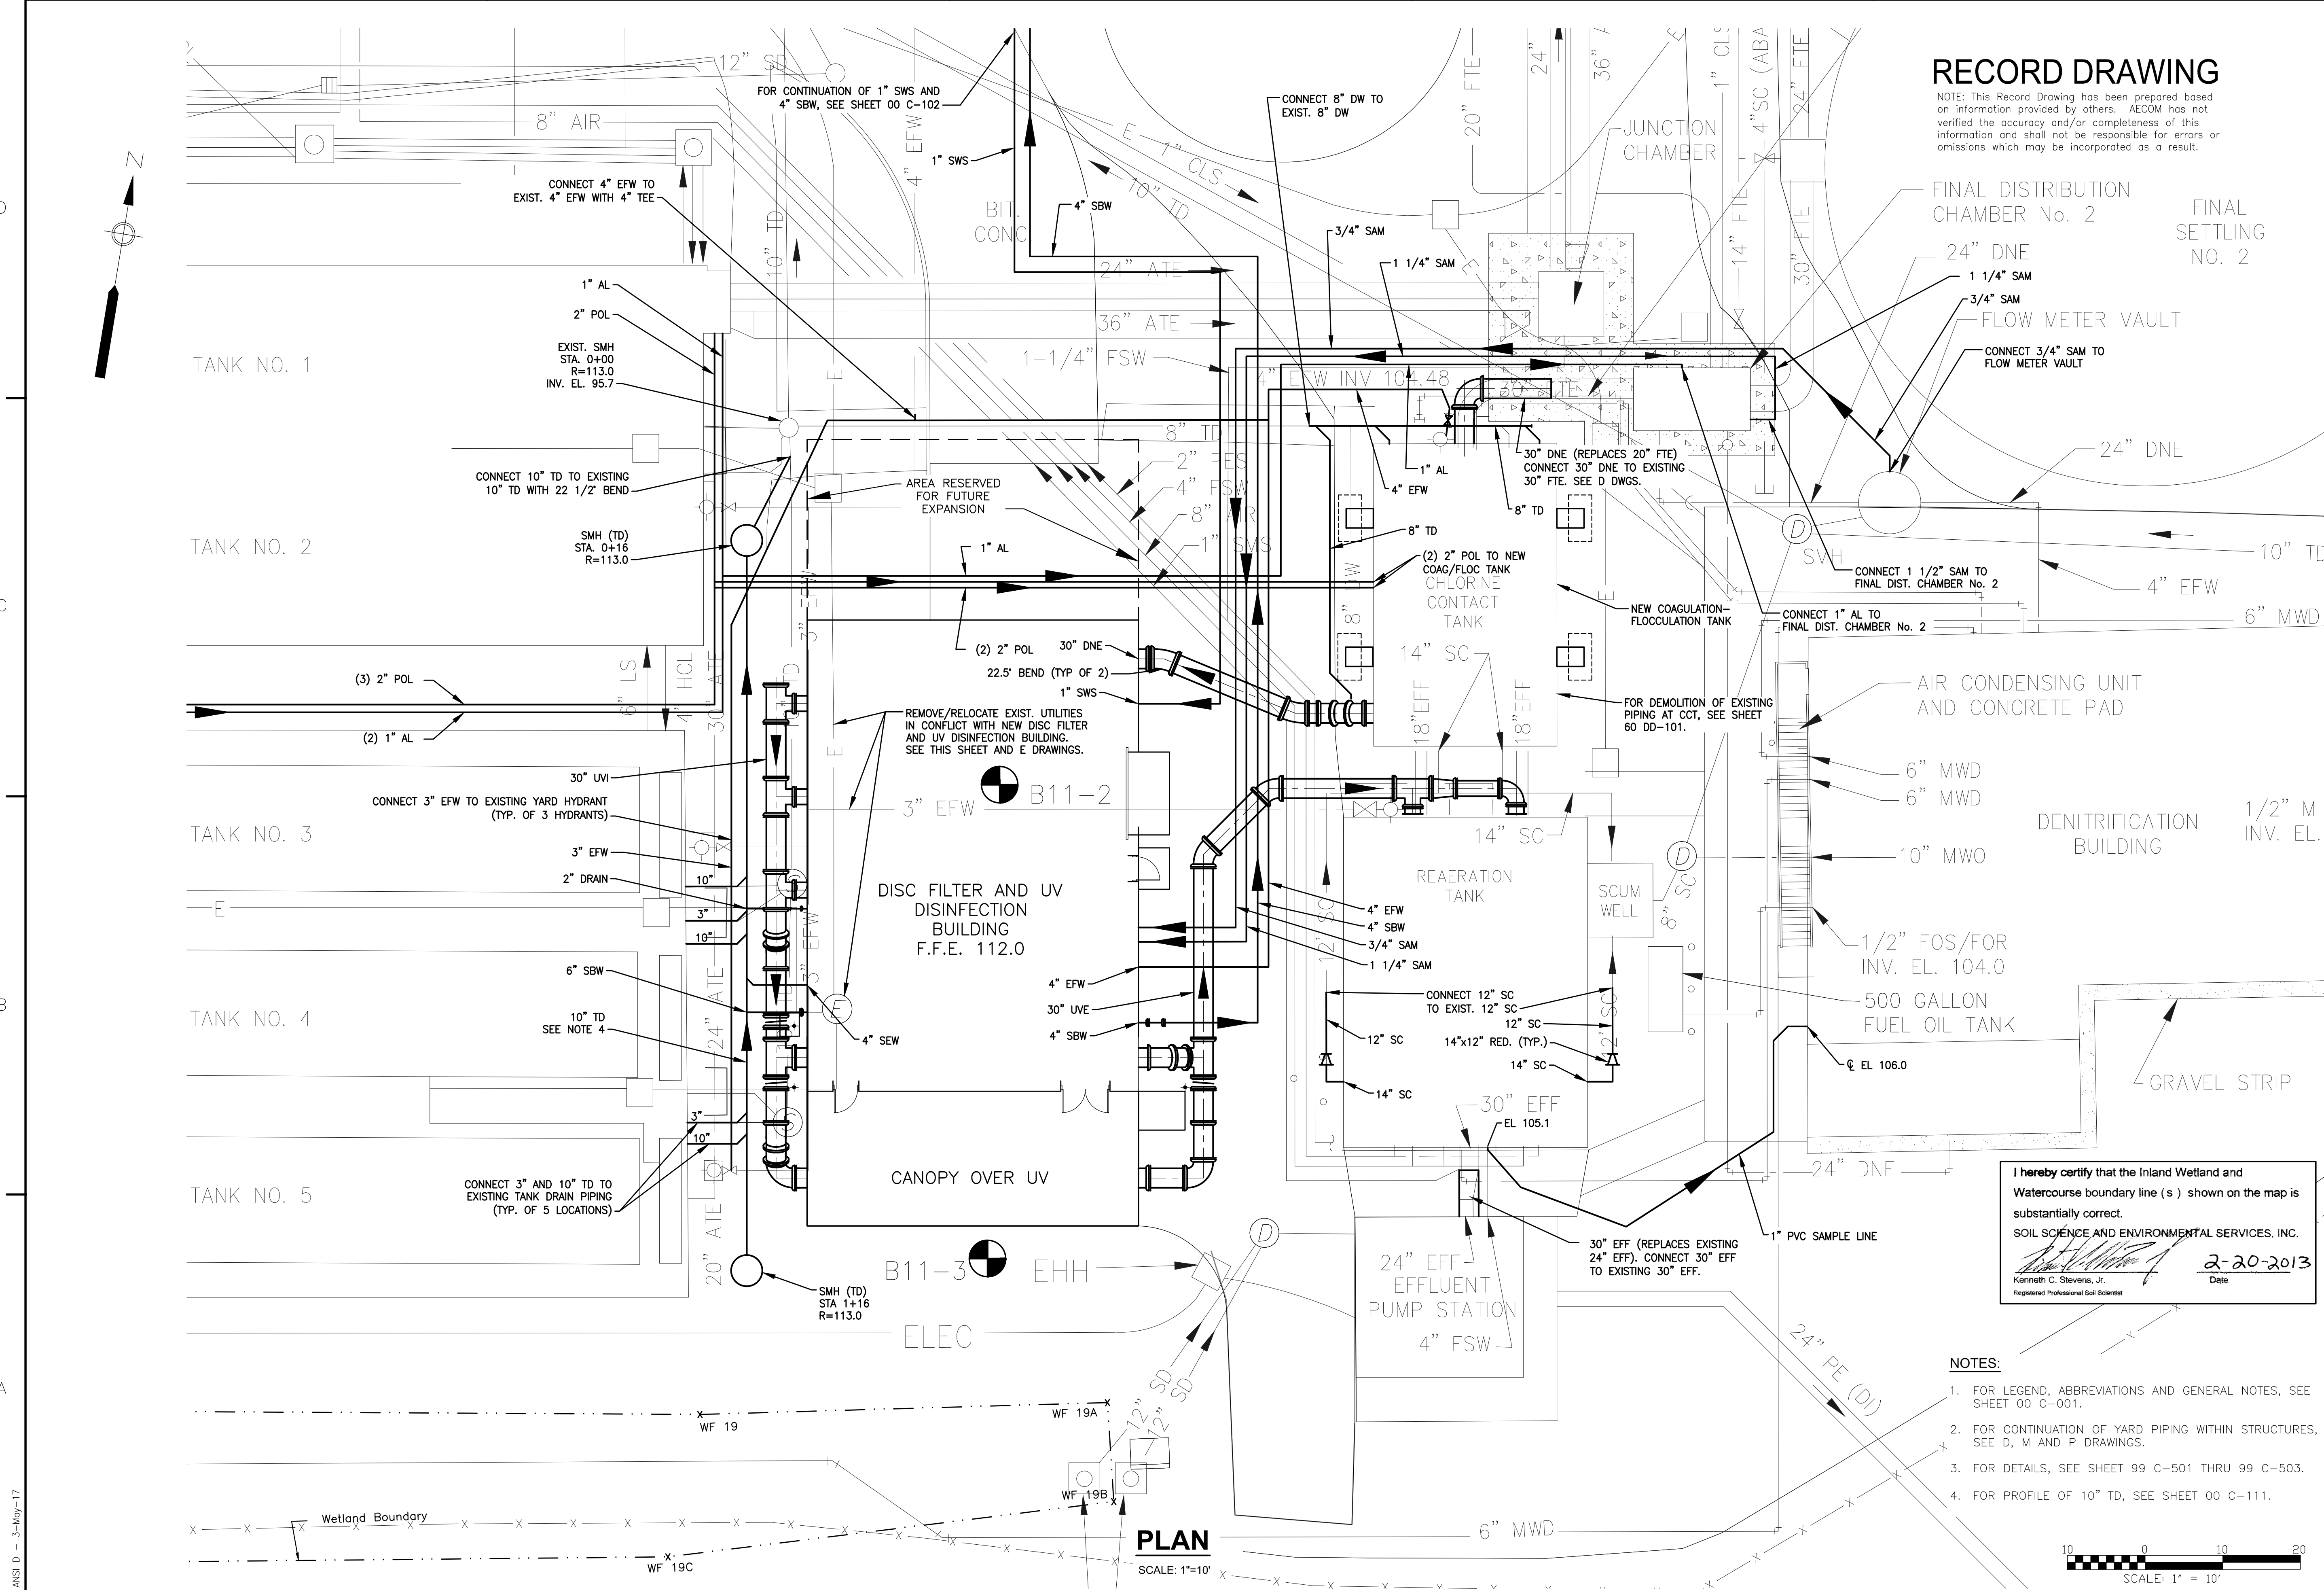

RECORD DRAWING
 NOTE: This Record Drawing has been prepared based on information provided by others. AECOM has not verified the accuracy and/or completeness of this information and shall not be responsible for errors or omissions which may be incorporated as a result.

REVISIONS	
MARK	DESCRIPTION
1	11/5/13 CB GS RELOCATE DISC FILTER AND UV BUILDING
2	2/19/14 CB GS PIPING REVISIONS
3	5/5/17 BS MF REVISED FOR RECORD DRAWINGS
	DATE MADE BY CHECKED


AECOM TECHNICAL SERVICES, INC.
 200 WEST STREET, SUITE 1000
 BOSTON, MASSACHUSETTS 02111
 PHONE (617) 805-2100
AECOM

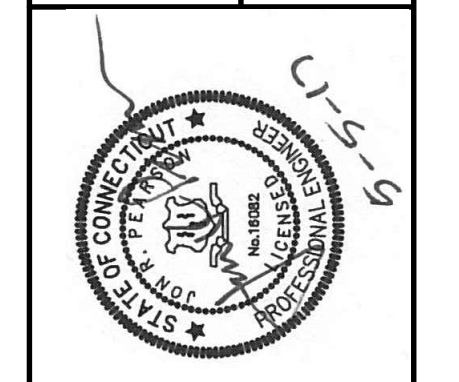

TOWN OF CHESHIRE, CONNECTICUT
 CHESHIRE WPCP UPGRADE
ENLARGED PLAN IV - DISC FILT. & UV DIS. BLD. - YARD PIPING PLAN
 CIVIL


I hereby certify that the Inland Wetland and Watercourse boundary line (s) shown on the map is substantially correct.
 SOIL SCIENCE AND ENVIRONMENTAL SERVICES, INC.
 Kenneth C. Stevens, Jr.
 Registered Professional Soil Scientist
 Date: 2-20-2013


- NOTES:**
- FOR LEGEND, ABBREVIATIONS AND GENERAL NOTES, SEE SHEET 00 C-001.
 - FOR CONTINUATION OF YARD PIPING WITHIN STRUCTURES, SEE D, M AND P DRAWINGS.
 - FOR DETAILS, SEE SHEET 99 C-501 THRU 99 C-503.
 - FOR PROFILE OF 10" TD, SEE SHEET 00 C-111.

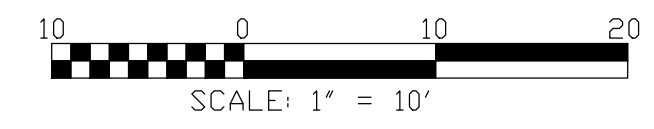


PLAN
 SCALE: 1"=10'

PROJECT NO:	60197025
CAD DWG FILE:	00 C-106
DESIGNED BY:	J. TRAINOR
DRAWN BY:	S. NAPOLITANO
DEPT CHECK:	C. BENZIGER
PROJ CHECK:	M. FORMICA
DATE:	MAY 2013
SCALE:	AS NOTED
00 C-106	
SHEET	OF

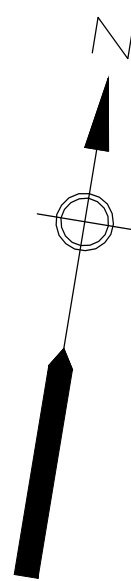

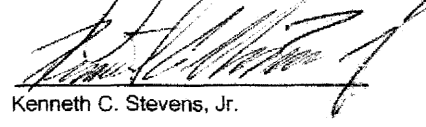I hereby certify that the Inland Wetland and Watercourse boundary line (s) shown on the map is substantially correct.
 SOIL SCIENCE AND ENVIRONMENTAL SERVICES, INC.

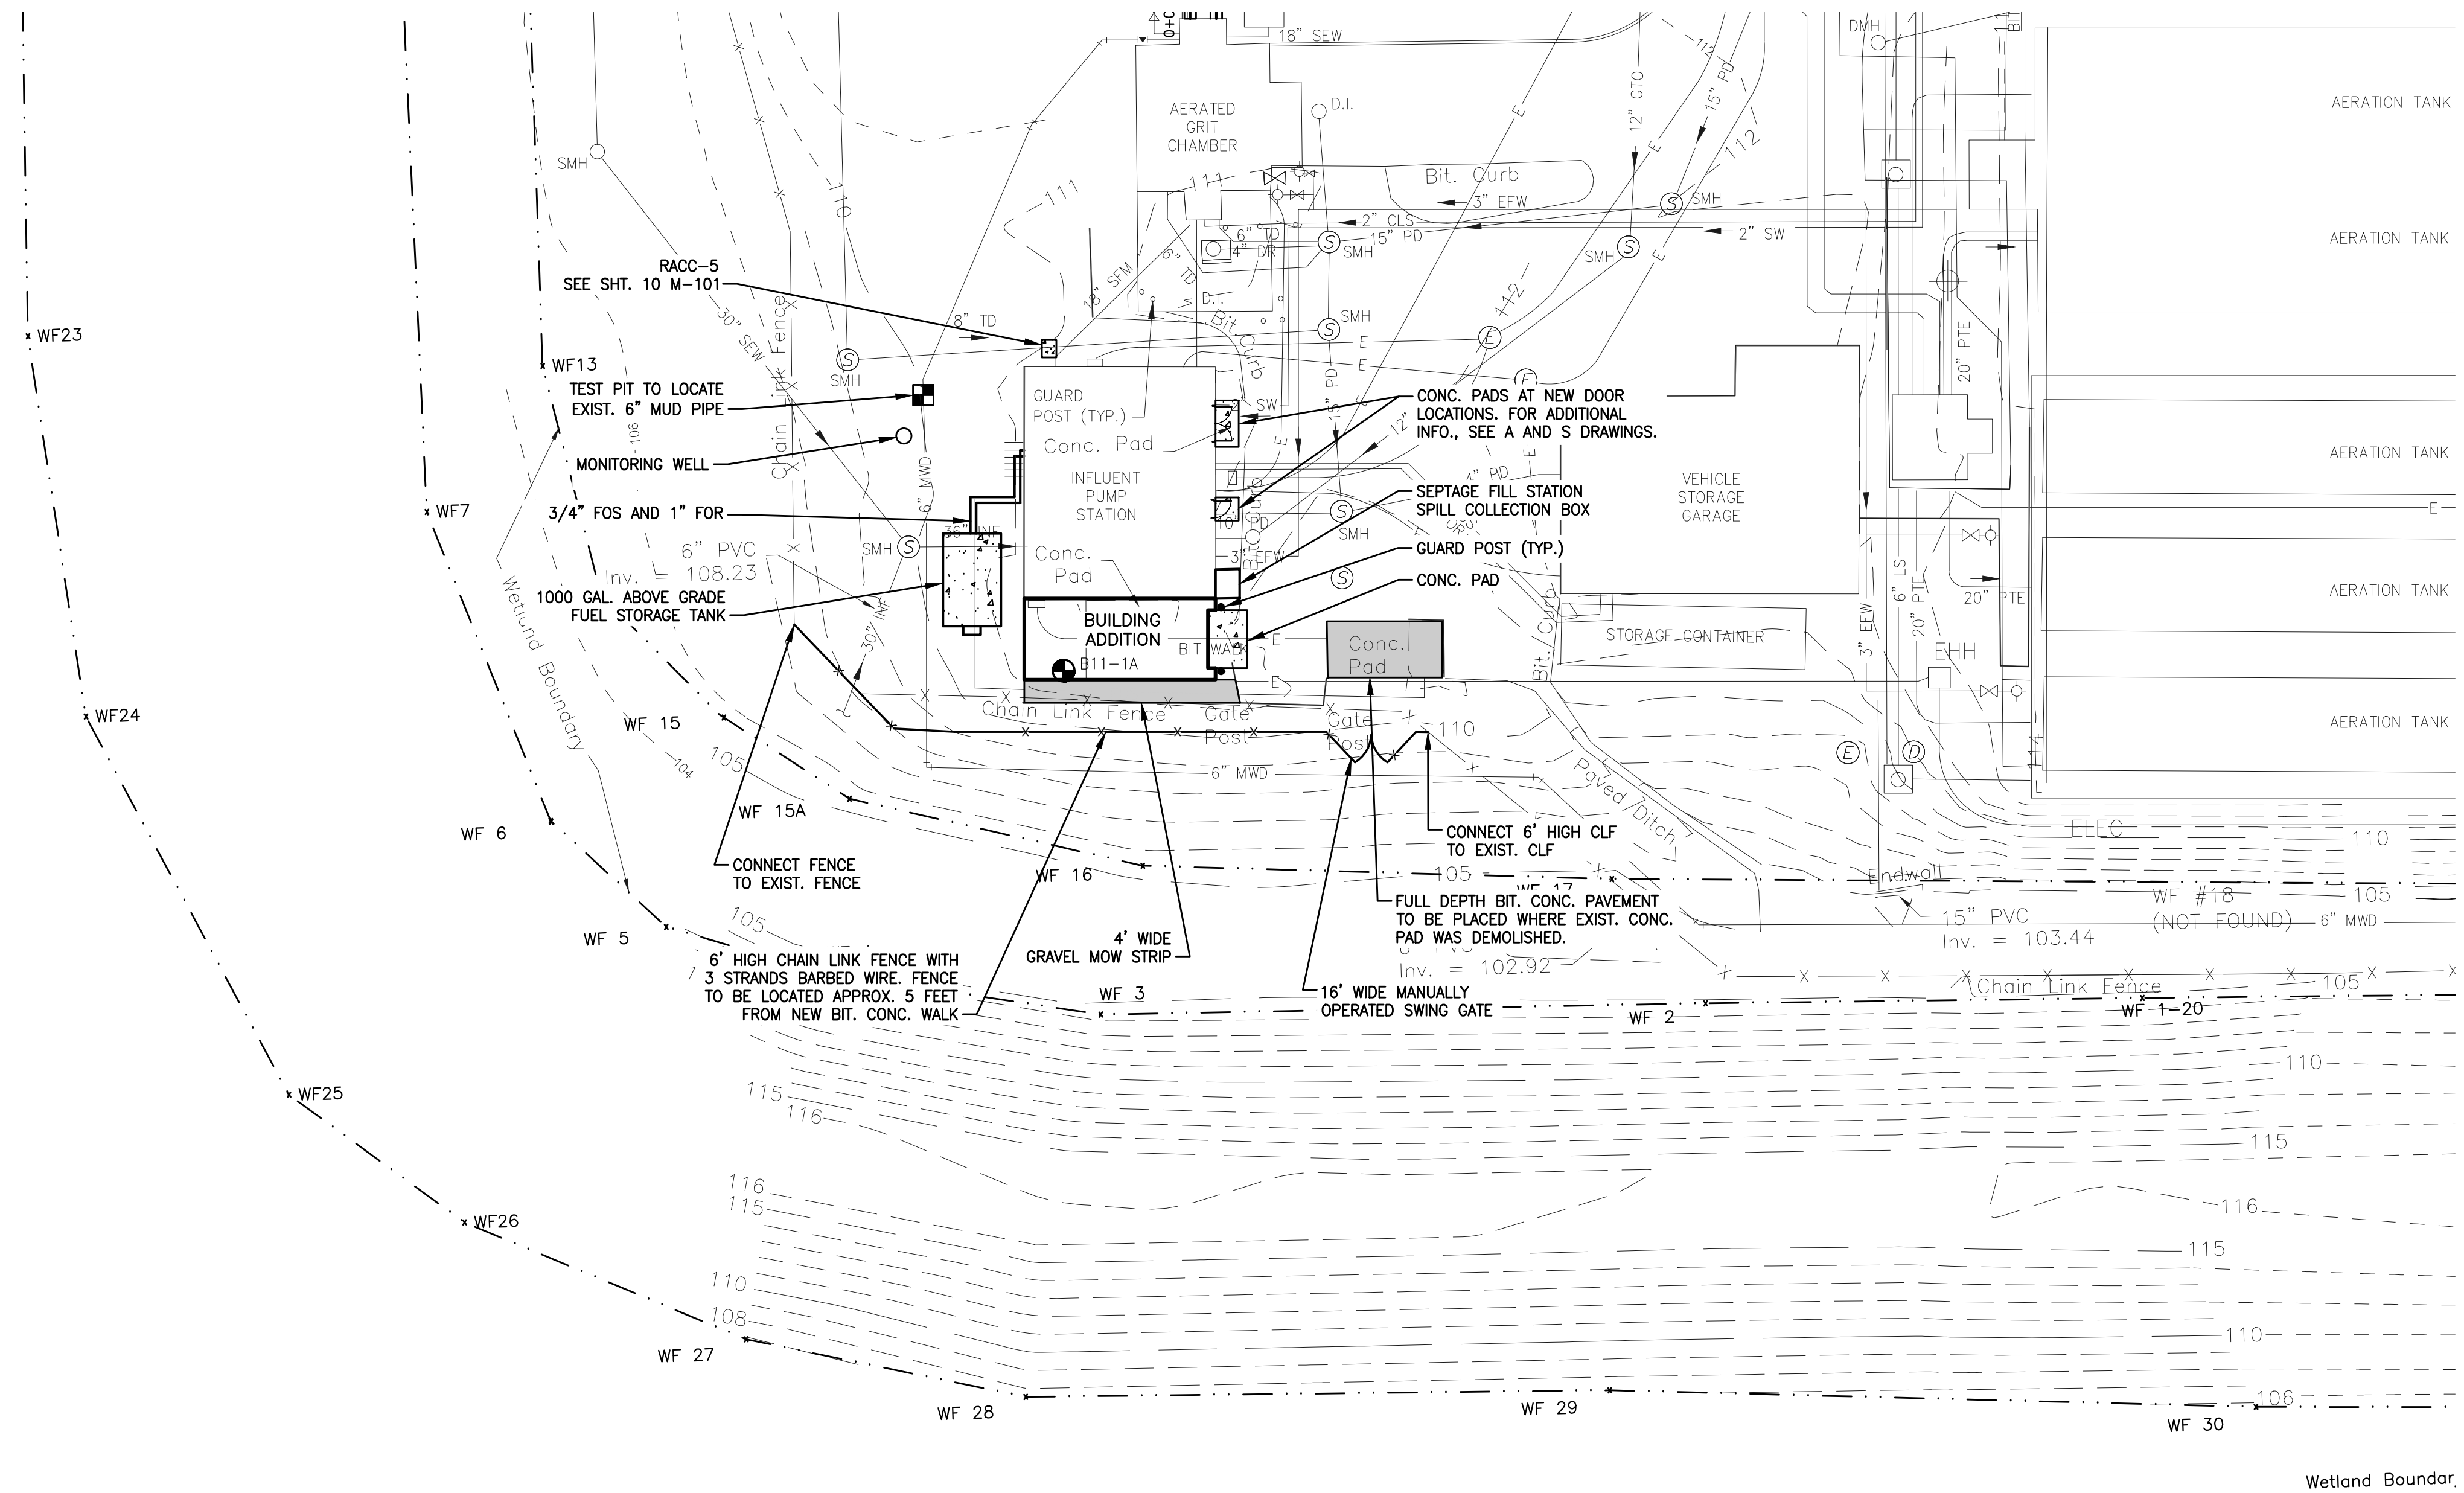 Kenneth C. Stevens, Jr.
 Registered Professional Soil Scientist
 Date: 2-20-2013




PLAN
 SCALE: 1"=20'

- NOTES:**
- FOR LEGEND, ABBREVIATIONS AND GENERAL NOTES, SEE SHEET 00 C-001.
 - FOR DETAILS, SEE SHEETS 99 C-501 THRU 99 C-503.

RECORD DRAWING


NOTE: This Record Drawing has been prepared based on information provided by others. AECOM has not verified the accuracy and/or completeness of this information and shall not be responsible for errors or omissions which may be incorporated as a result.

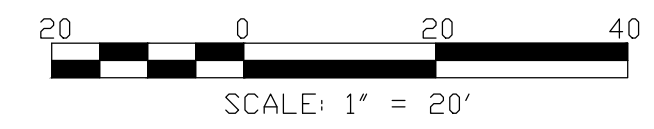

REVISIONS	DESCRIPTION
1	5/5/17 BS DATE MADE BY CHECKED MARK

AECOM TECHNICAL SERVICES, INC.
 200 WASHINGTON ST., SUITE 1000
 BOSTON, MA 02108
 PHONE (978) 905-1100

AECOM

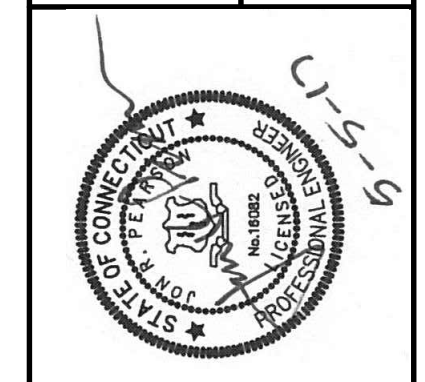


TOWN OF CHESHIRE, CONNECTICUT
 CHESHIRE WPCP UPGRADE
**ENLARGED PLAN V -
 INFLUENT PUMP STATION -
 SITE LAYOUT PLAN**
 CIVIL

PROJECT NO:	60197025
CAD DWG FILE:	00 C-107
DESIGNED BY:	J. TRAINOR
DRAWN BY:	S. NAPOLITANO
DEPT CHECK:	C. BENZIGER
PROJ CHECK:	M. FORMICA
DATE:	MAY 2013
SCALE:	AS NOTED
00 C-107	SHEET OF

PATH/FILENAME: F:\60197025 - CHESHIRE WPCP UPGRADE\SHEETS\00 C-107.DWG
 LAST UPDATE: Tuesday, May 09, 2017 12:40:29 PM
 PLOT DATE: Tuesday, May 09, 2017 1:54:20 PM
 ANSI D - 9-May-17

PATH/FILENAME: P:\60197025 - CHESHIRE WPCP UPGRADE\SHEETS\C-108.DWG
 LAST UPDATE: Friday, April 21, 2017 3:56:13 PM
 PLOT DATE: Tuesday, May 09, 2017 1:54:24 PM

ANSI D - 21-Apr-17

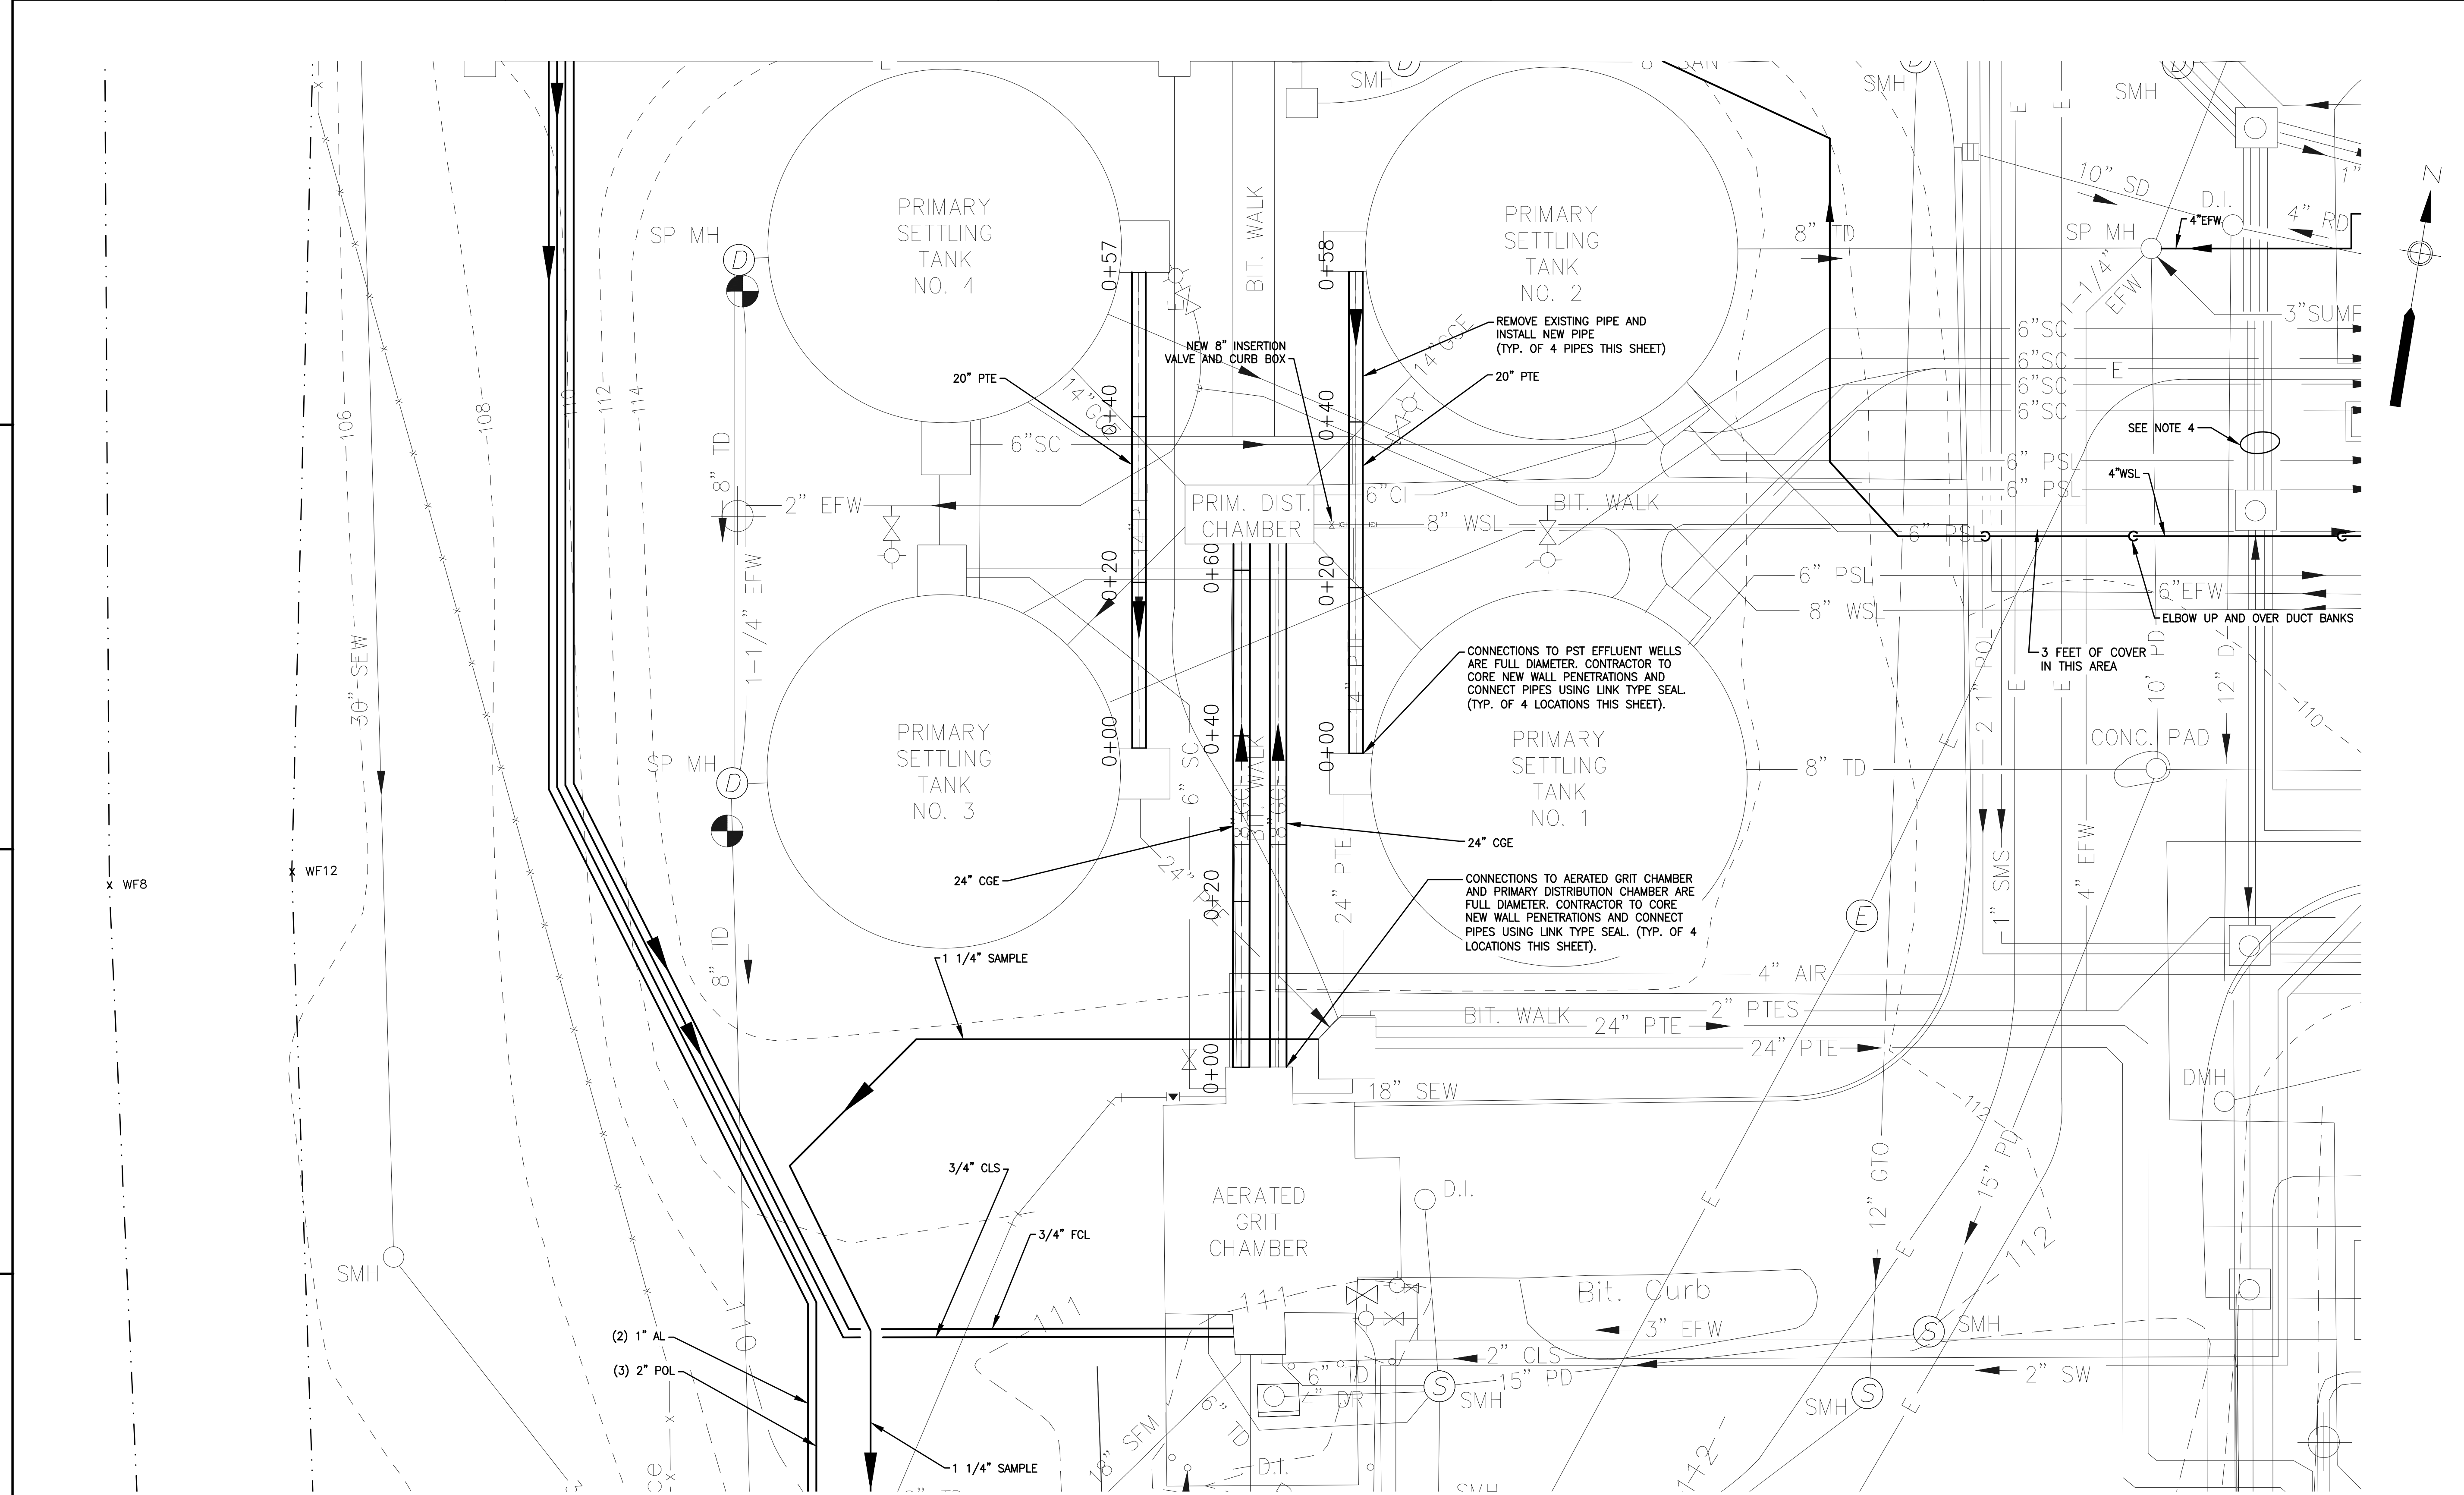

PLAN
 SCALE: 1"=10'

- NOTES:**
- FOR LEGEND, ABBREVIATIONS AND GENERAL NOTES, SEE SHEET 00 C-001.
 - FOR CONTINUATION OF YARD PIPING WITHIN STRUCTURES, SEE D, M AND P DRAWINGS.
 - FOR DETAILS, SEE SHEET 99 C-501 THRU 99 C-503.
 - FOR PROFILES, SEE SHEETS 00 C-110 AND 00 C-111.

RECORD DRAWING
 NOTE: This Record Drawing has been prepared based on information provided by others. AECOM has not verified the accuracy and/or completeness of this information and shall not be responsible for errors or omissions which may be incorporated as a result.

SCALE: 1" = 10'

REVISIONS	
MARK	DESCRIPTION
1	5/5/17 BS DATE MADE BY CHECKED
	MF REVISED FOR RECORD DRAWINGS

AECOM TECHNICAL SERVICES, INC.
 200 WASHINGTON ST., SUITE 200
 BOSTON, MA 02108
 PHONE (978) 405-2100


AECOM

TOWN OF CHESHIRE, CONNECTICUT
 CHESHIRE WPCP UPGRADE
ENLARGED PLAN VI -
PRIMARY SETTLING TANK
AREA - YARD PIPING PLAN
 CIVIL

PROJECT NO: 60197025
 CAD DWG FILE: 00 C-108
 DESIGNED BY: J. TRAINOR
 DRAWN BY: S. NAPOLITANO
 DEPT CHECK: C. BENZIGER
 PROJ CHECK: M. FORMICA
 DATE: MAY 2013
 SCALE: AS NOTED

00 C-108
 SHEET OF

PATH/FILENAME: F:\60197025 - CHESHIRE WPCP UPGRADE\SHEETS\00 D-007.DWG
 LAST UPDATE: Friday, May 05, 2017 11:16:24 AM
 PLOT DATE: Friday, May 05, 2017 12:48:32 PM
 ANSI D - 5-May-17

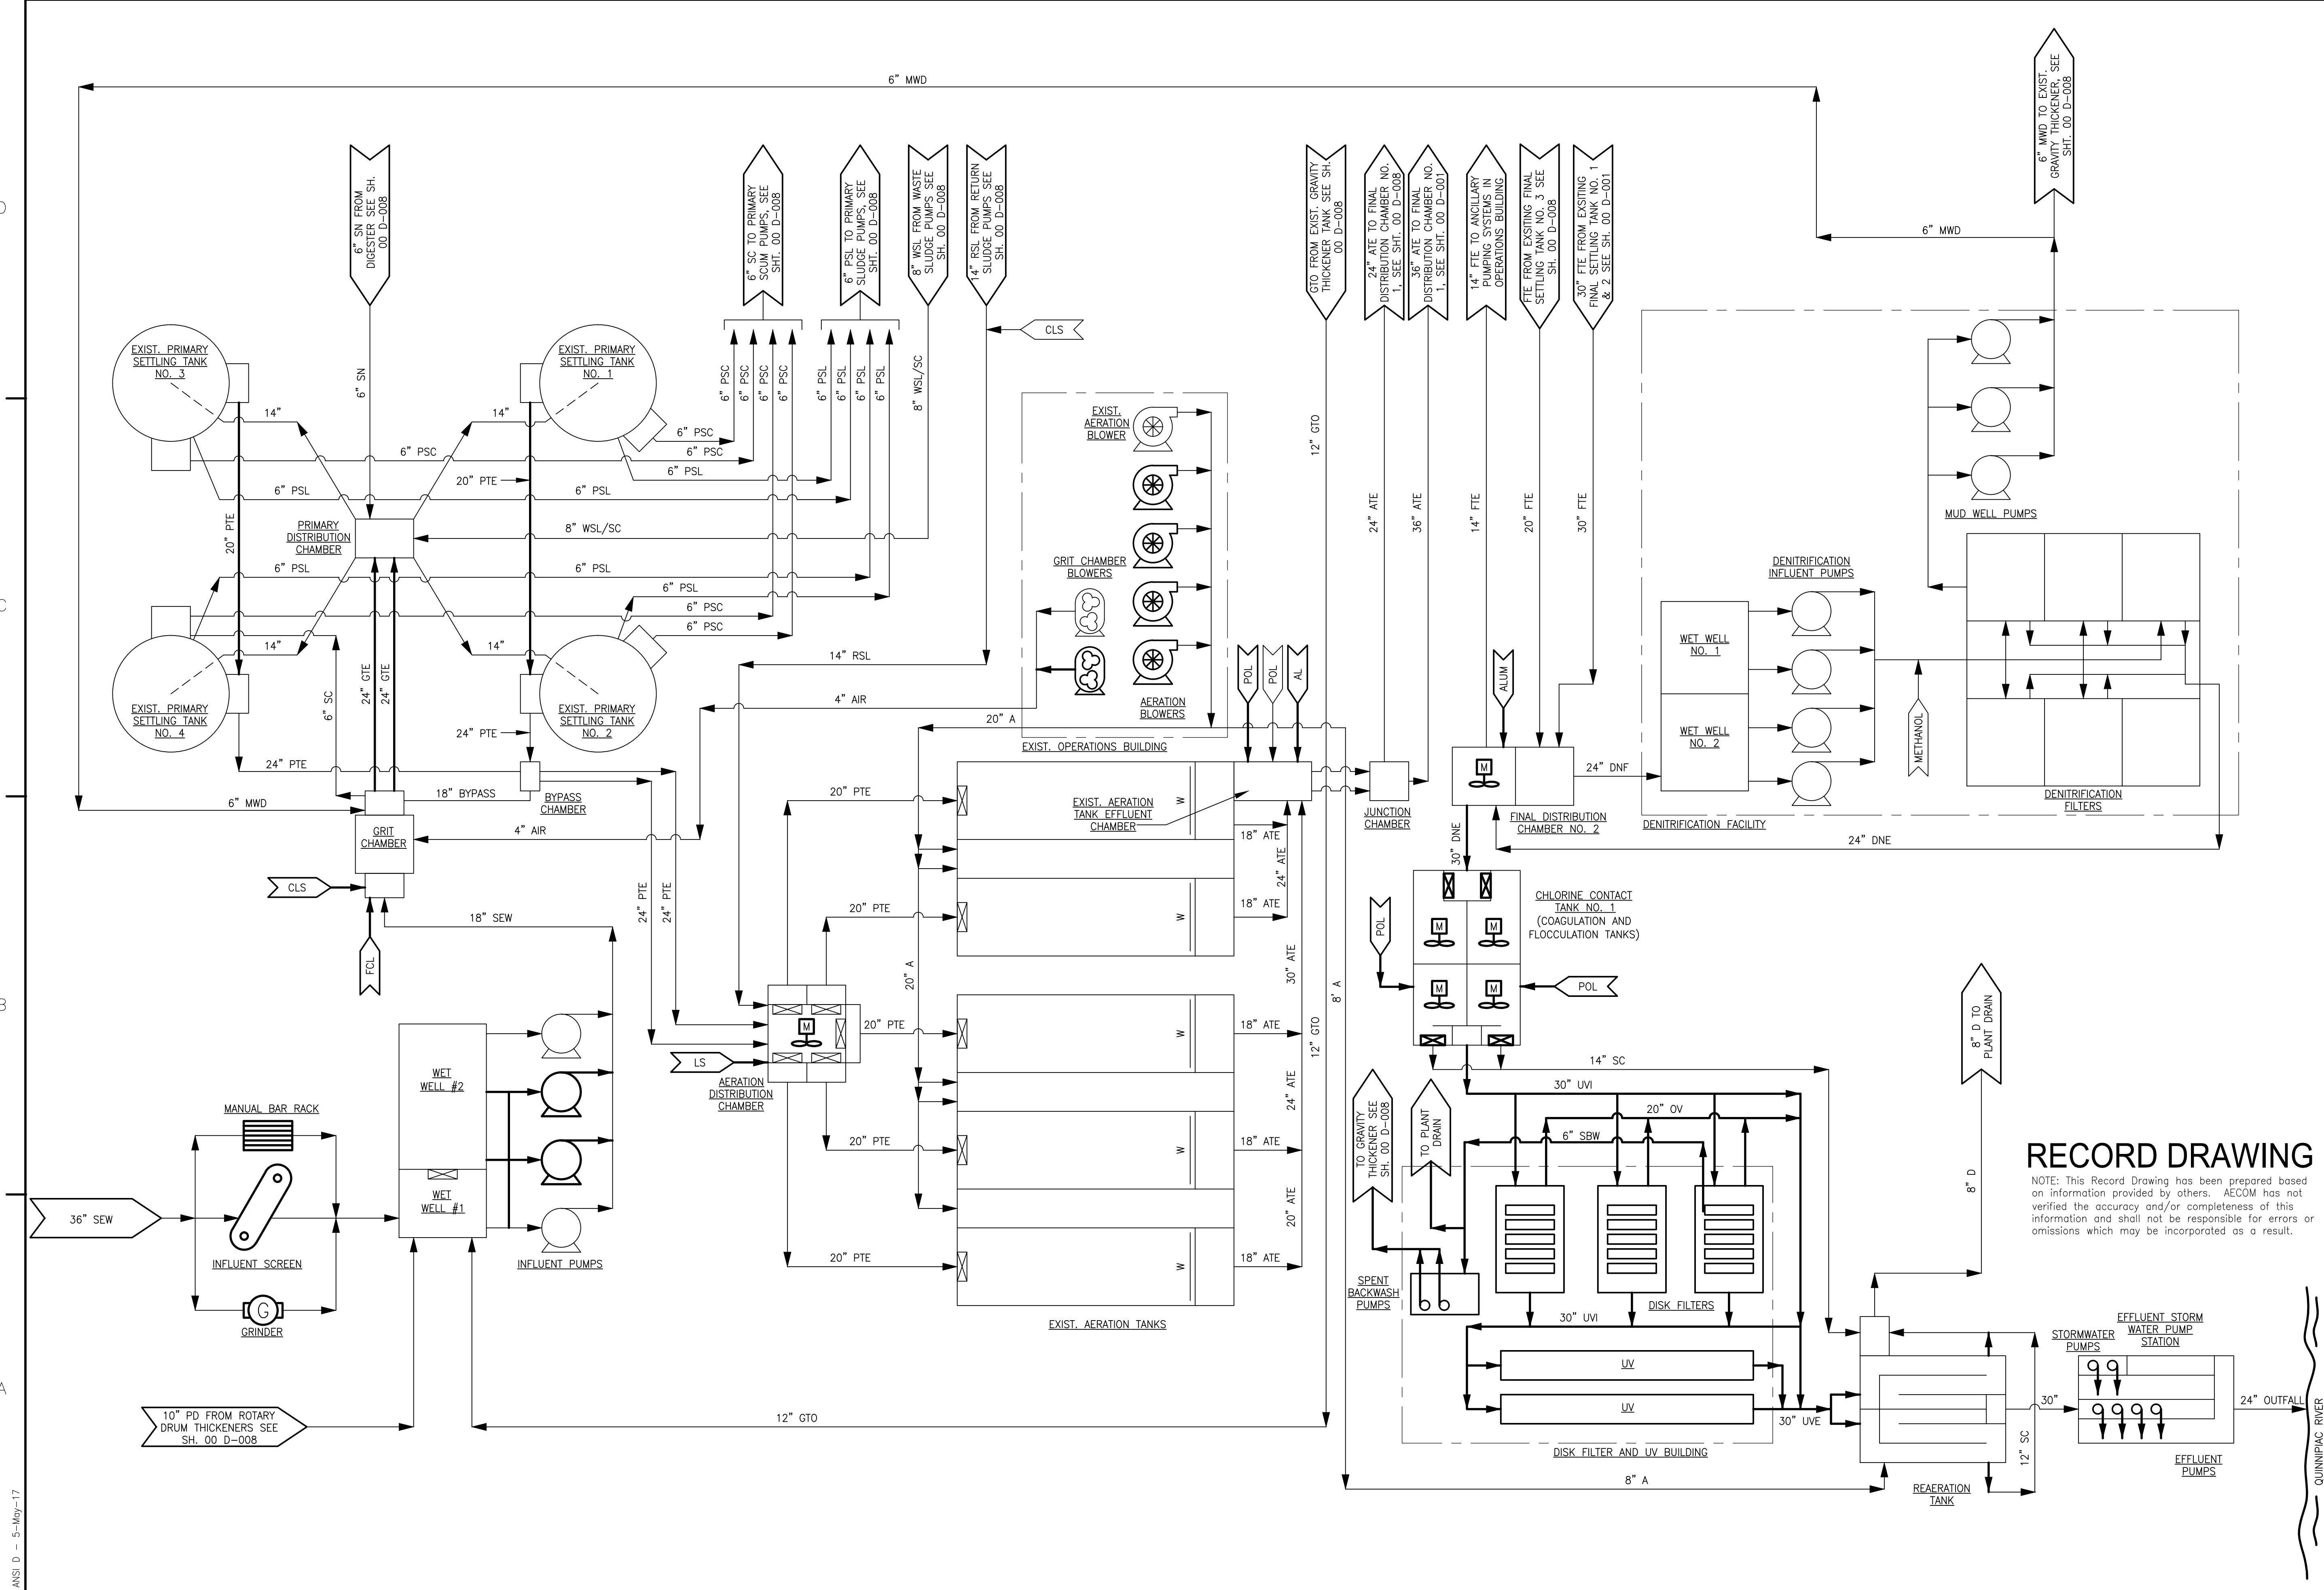


RECORD DRAWING
 NOTE: This Record Drawing has been prepared based on information provided by others. AECOM has not verified the accuracy and/or completeness of this information and shall not be responsible for errors or omissions which may be incorporated as a result.

		TOWN OF CHESHIRE, CONNECTICUT CHESHIRE WPCP UPGRADE	
		PROJECT NO: 60197025 CAD DWG FILE: 00 D-007	
PROJECT NO: 60197025 CAD DWG FILE: 00 D-007		DESIGNED BY: K. RACAN DRAWN BY: S.A. COTE	
PROJECT NO: 60197025 CAD DWG FILE: 00 D-007		DEPT CHECK: C. GALLIGAN PROJ CHECK: M. FORMICA	
PROJECT NO: 60197025 CAD DWG FILE: 00 D-007		DATE: MAY 2013 SCALE: N.T.S.	
PROJECT NO: 60197025 CAD DWG FILE: 00 D-007		00 D-007 SHEET OF	

PATH/FILENAME: P:\60197025 - CHESHIRE WPCP UPGRADE\SHEETS\00 D-008.DWG
 LAST UPDATE: Thursday, March 02, 2017 5:21:46 PM
 PLOT DATE: Friday, May 05, 2017 12:48:34 PM

ANSI D - 2-MAR-17

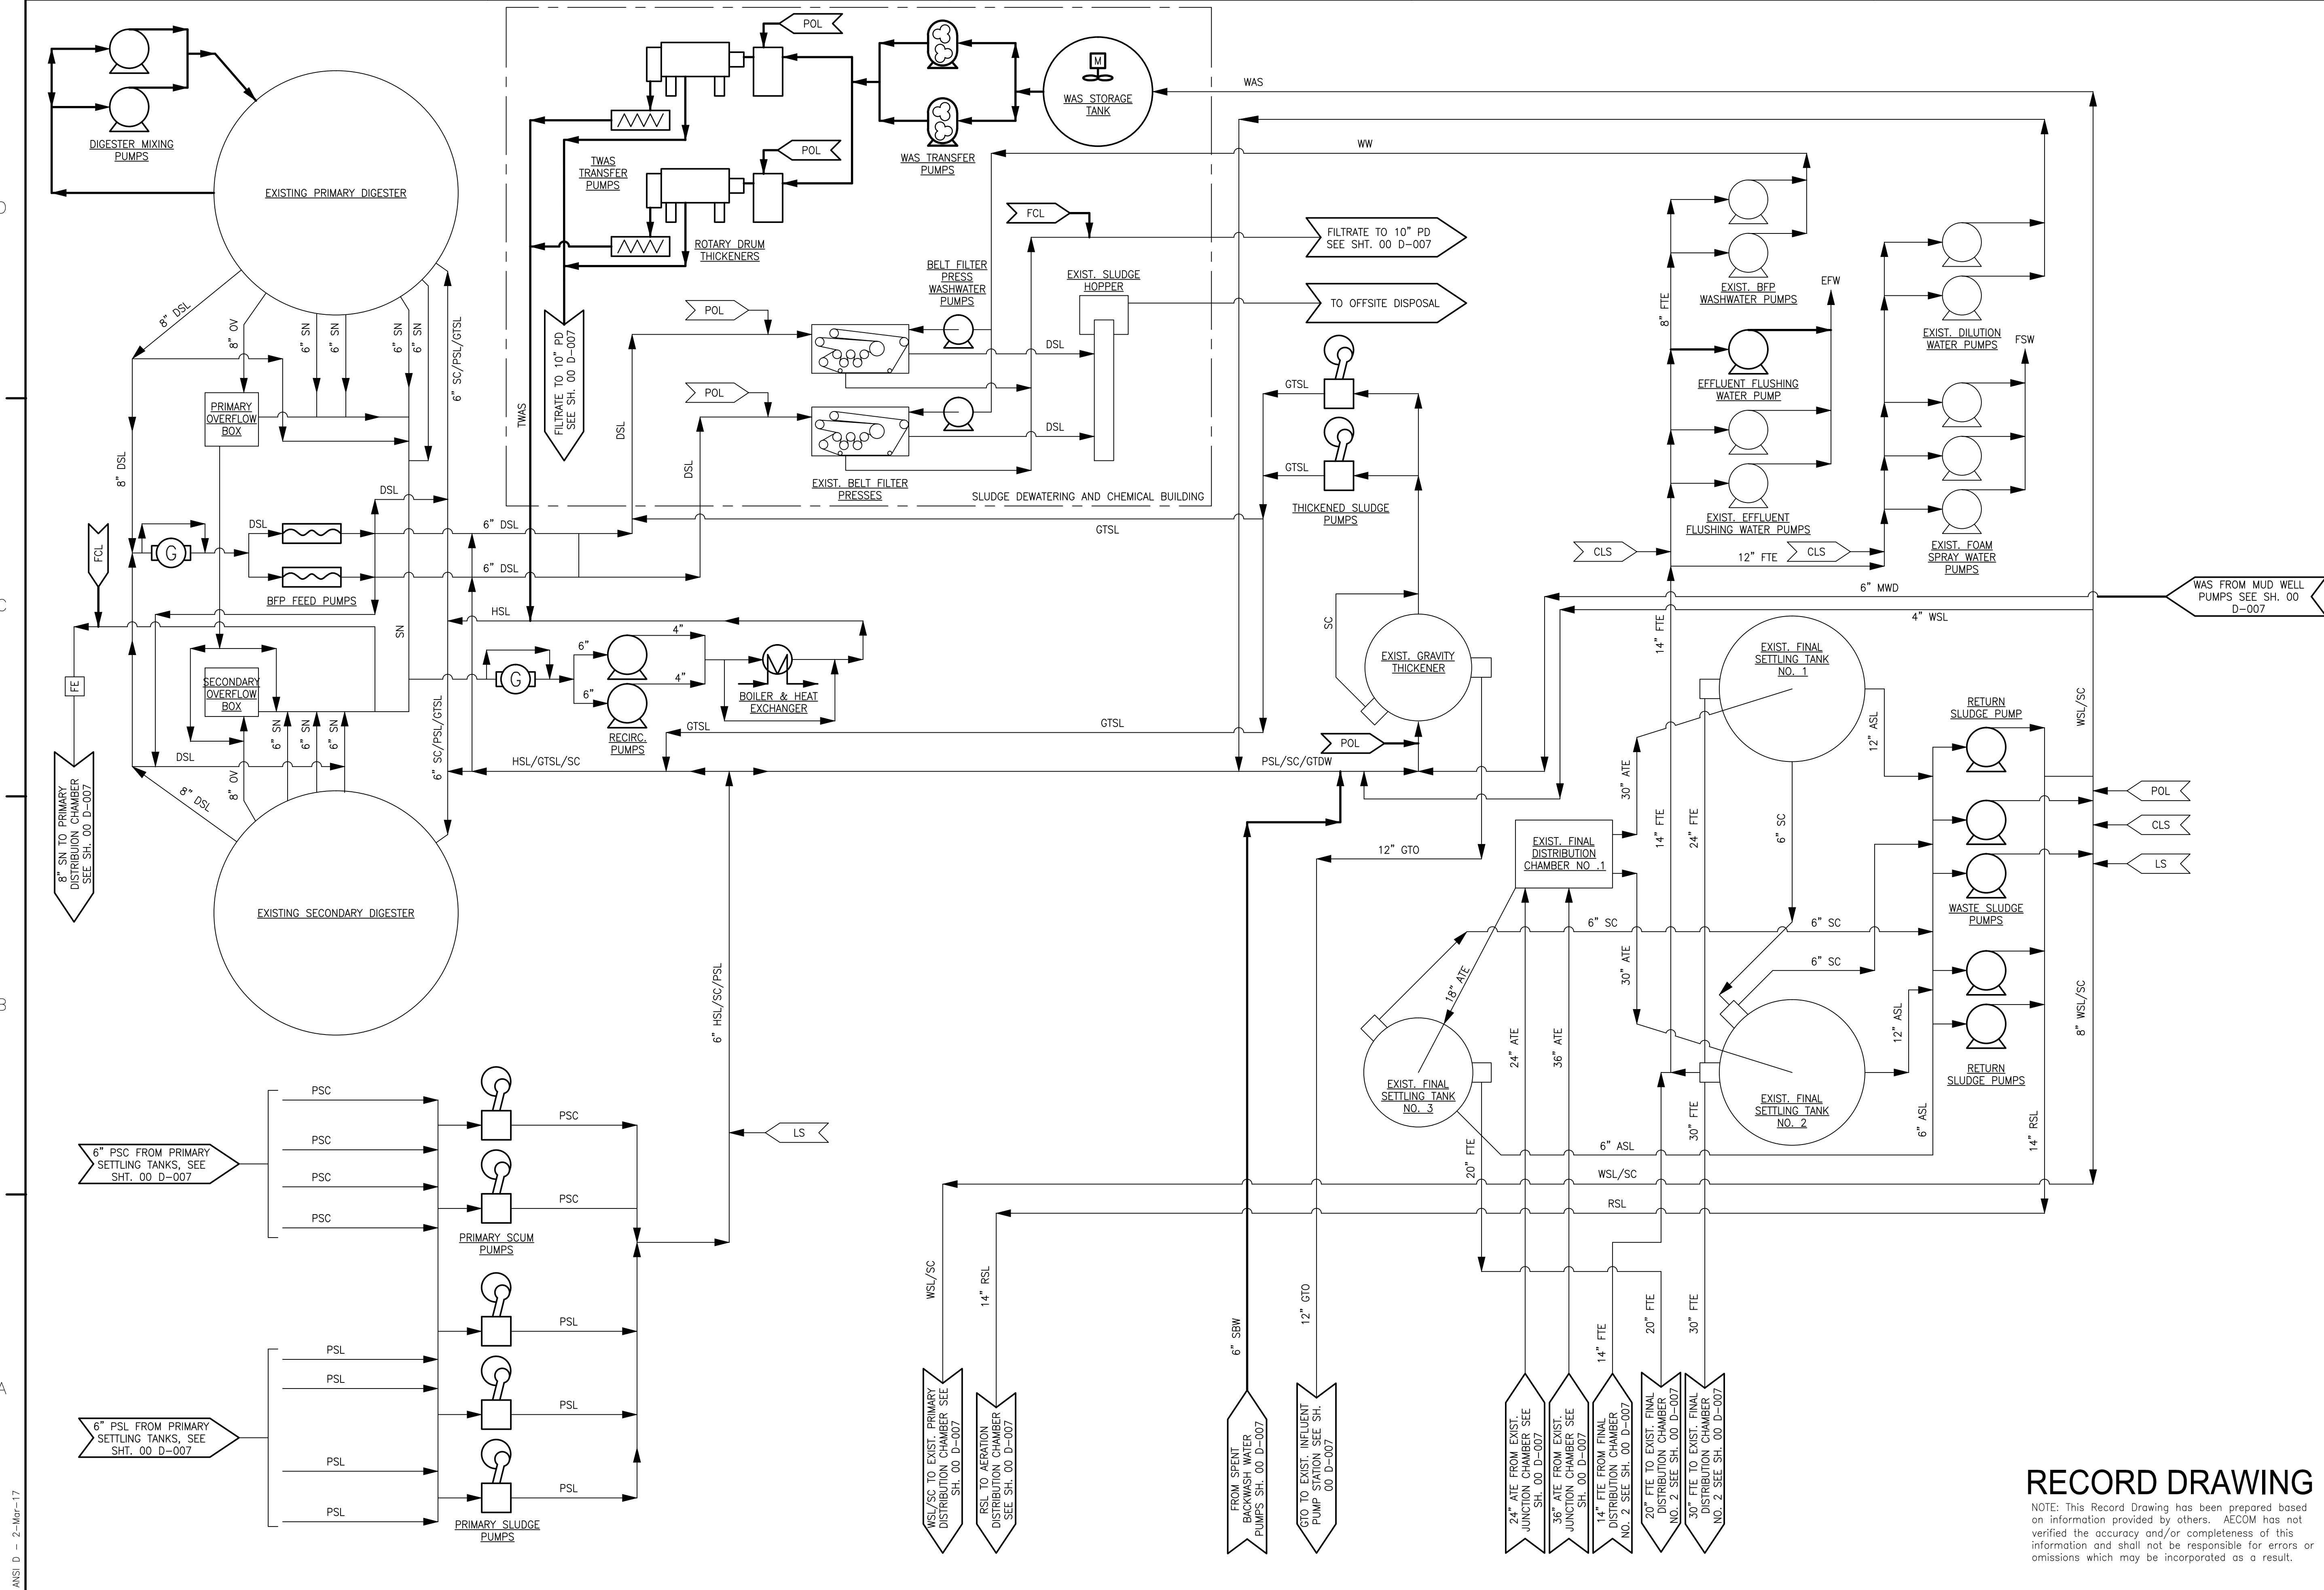

AECOM <small>AECOM TECHNICAL SERVICES, INC. 200 WASHINGTON ST., SUITE 200 WASHINGTON, MA 01884 PHONE (978) 805-2100</small>		REVISIONS <table border="1"> <tr> <th>MARK</th> <th>DATE</th> <th>MADE BY</th> <th>CHECKED</th> <th>DESCRIPTION</th> </tr> <tr> <td>1</td> <td>5/5/17</td> <td>BS</td> <td>MF</td> <td>REVISED FOR RECORD DRAWINGS</td> </tr> </table>	MARK	DATE	MADE BY	CHECKED	DESCRIPTION	1	5/5/17	BS	MF	REVISED FOR RECORD DRAWINGS
MARK	DATE	MADE BY	CHECKED	DESCRIPTION								
1	5/5/17	BS	MF	REVISED FOR RECORD DRAWINGS								
TOWN OF CHESHIRE, CONNECTICUT CHESHIRE WPCP UPGRADE												
PROCESS FLOW DIAGRAM II MECHANICAL PROCESS		PROJECT NO: 60197025 CAD DWG FILE: 00 D-008 DESIGNED BY: K. RACAN DRAWN BY: S.A. COTE DEPT CHECK: C. GALLIGAN PROJ CHECK: M. FORMICA DATE: MAY 2013 SCALE: N.T.S.										
RECORD DRAWING <small>NOTE: This Record Drawing has been prepared based on information provided by others. AECOM has not verified the accuracy and/or completeness of this information and shall not be responsible for errors or omissions which may be incorporated as a result.</small>		00 D-008 SHEET OF										

**TABLE 1-3. DETAILED DESIGN DATA
CHESHIRE WPCP**

Design Data	
PRETREATMENT	
Mechanically Cleaned Mechanical Screen	
Number of Units	1
Type	Mechanically Cleaned
Number on line	1
Screen Opening Size, in	0.5
Hydraulic Capacity, mgd	11 mgd
Influent Channel Grinder (screen back up)	
Number of Units	1
Number on line	1
Size, Total HP	7
Hydraulic Capacity, mgd	7.75 mgd
Bypass Bar Rack	
Number of Units	1
Width, in	1-3/8
Channel Flow Meter	
Type	Parshall Flume
Throat Size, in.	12
Range, mgd	0.1 – 8
Raw Wastewater Pumps	
Large Pumps	
Number of Pumps	2
Type: pump drive speed	Solids Handling Dry Pit Submersible Close Coupled Variable
Unit Capacity, gpm @ TDH	2 @ 4,167 gpm @ 52 ft.
Small Pumps	
Number of Pumps	2
Type: pump drive speed	Solids Handling Dry Pit Submersible Close Coupled Variable
Unit Capacity, gpm @ TDH	2 @ 2,000 gpm @ 52 ft.

TABLE 1-3. Continued

		Design Data
Force Main Flow Meter		
Type		Magnetic
Diameter, in.		18
Range, mgd		0.8 – 14
Aerated Grit Chambers		
Number of Tanks		2
Tank Dimensions		
Length, ft		20
Width, ft		10
Average Water Depth, ft		7.6
Unit Area, sf		200
Total Area, sf		400
Unit Volume		
Cf		1,520
gal.		11,370
Total Volume		
Cf		3,040
gal.		22,740
Detention Time, min		
At Average Design Flow		7.6
At Peak Flow		2.9
Air Supply Range, cfm/ft.		1.5-4.5
Total Supply Range, cfm/ft.		60-180
Aerated Grit Chamber Blowers		
Number of Units		2
Type		Rotary, positive displacement
Capacity		180 SCFM @ 4psi
Drive		1- V-belt, 1- VFD
Horsepower		10
CHEMICAL PHOSPHORUS REMOVAL		
(First Dosing Location)		
2 nd dosing location after Denitrification Facilities		
Ferric Chloride Storage		
Number of Tanks		2
Unit Capacity, gallons		5,375

TABLE 1-3. Continued

Design Data	
Ferric Chloride Feed Pumps	
Dosing Location	Aerated Grit Chamber
Number of Pumps	2
Type: Pump	Peristaltic
Drive	Direct Variable Speed
Unit Capacity, gph @ 125 psi	15
Dosing Location	Belt Filter Press Filtrate
Number of Pumps	1
Type: Pump	Peristaltic
Drive	Direct Variable Speed
Unit Capacity, gph @ 125 psi	33
Dosing Location	Digester Supernatant
Number of Pumps	1
Type: Pump	Hose
Drive	Direct Variable Speed
Unit Capacity, gph @ 30 psi	527
 PRIMARY TREATMENT	
Primary Settling Tanks	
Number of tanks	4
Diameter, ft.	40
Sidewater Depth, ft.	10
Volume Each, gal.	93,949
Volume Total, gal.	375,795
Surface Area each, sf.	1,256
Surface Area total, sf.	5,024
Surface Overflow rate	
Avg. Flow, gpd/sf	862
Max Day Flow, gpd/sf	2,275
Solids Loading Rate	
Avg. Flow, lb/d/sf	1.25
Max Day Flow, lb/d/sf	2.28
Detention Time	
Avg. Flow, hours	2.08
Max Day Flow, hours	0.79
Sludge Removal	
Avg. Daily, lbs/d	6,684
Concentration, Percent	4.5
Avg. Daily, gal/d	17,800

TABLE 1-3. Continued

		Design Data
Primary Sludge Pumps		
Number of Pumps		3
Type: Pump		Simplex Plunger
Drive		Variable Speed
Unit Capacity, gpm @ TDH		95 @ 33
Primary Scum Pumps		
Number of Pumps		2
Type: Pump		Simplex Plunger
Drive		Variable Speed
Unit Capacity, gpm @ TDH		75 @ 120
 SECONDARY TREATMENT		
Activated Sludge Tanks		
Number of Tanks		5
Sidewater Depth, ft		15
Length Each Tank, ft		121
Width Each Tank, ft		21
Unit Volume		
Cf		38,115
Gal.		285,100
Aeration Blowers		
Number of Units		4 High Speed Turbocompressor 1 Multistage Centrifugal
Max System Requirements, scfm		13,324
HST (High Speed Turbocompressor)		
Motor HP		2 @ 268 and 2 @ 120
Drive		VFD
Unit Capacity, scfm		2 @ 5,420; 2 @ 2,300
Max System Requirements, scfm		13,234
HST (High Speed Turbocompressor)		
Motor HP		1 @ 200
Drive		Direct
Unit Capacity, scfm		3,300
Summer Conditions		
Max Month		
Number of Small Blowers in Service		0
Number of Large Blowers in Service		2
Air Required for Tanks, scfm		7,260

TABLE 1-3. Continued

	Design Data
Peak Conditions	
Number of Small Blowers in Service	
Number of Small Blowers in Service	2
Number of Large Blowers in Service	2
Air Required for Tanks, scfm	13,234
Winter Conditions	
Max Month	
Number of Small Blowers in Service	0
Number of Large Blowers in Service	2
Air Required for Tanks, scfm	7,364
Peak Conditions	
Number of Small Blowers in Service	0
Number of Large Blowers in Service	2
Air Required for Tanks, scfm	10,143
Final Settling Tanks	
Number of Units	3
Diameter, feet	1 @ 40 and 2 @ 80
Sidewater depth, feet	12
Volume Each, gal.	1 @ 112,739 and 2 @ 450,954 ea.
Volume Total, gal.	1,014,647
Surface Area each, sf.	1 @ 1,256 and 2 @ 5,024 ea.
Surface Area total, sf.	11,304
Number of units in service	2 @ 80 ft
Total Surface area in service, sf	10,053
Surface Overflow rate	
Avg. Flow, gpd/sf	431
Max Day Flow, gpd/sf	1,137
Solids loading rate	
Avg. MLSS Applied, lb/day	108,300
Solids Loading Rate, lb/d/sf	10.8
Drive motor HP	¾
Return Sludge Pumps	
Number of pumps	3
Type: Pump	Vertical Solids Handling
Drive	Variable Frequency
Capacity, gpm @ 47 ft TDH	1,800
Total capacity, 2 pumps, gpm	3,600

TABLE 1-3. Continued

	Design Data
Maximum Return Sludge Capacity, percent of maximum month flow	100%
Waste Sludge Pumps	
Number of pumps	2
Type: Pump	Dry Pit Submersible
Drive	Variable Frequency
Capacity, gpm @ 53 ft TDH	200
DENITRIFICATION FILTER SYSTEM	
Influent Well Screens	
Number of Units	2
Type and Screen Opening	¼-inch opening bar rack
Screenings Handling Method	Hand raked
Hydraulic Capacity: Design Avg. Flow	1,250 gpm (1.8 mgd)/screen
Hydraulic Capacity: Design Peak Flow	2,708 gpm (3.9 mgd)/screen
Influent Wetwells	
Design Flows	
Flow, mgd	
Average daily	3.5
Hourly peak	7.75
Design Data	
Number of Wells	2
Number of Wells in Service	2
Main Denitrification Influent Pumps	
Number of Pumps	3
Type	Dry pit, Submersible, Centrifugal
Drive	variable frequency drive
Horsepower	40
Speed-max., rpm	850
Capacity per Pump, mgd	3.4
Jockey Denitrification Influent Pump	
Number of Pumps	1
Type.	Dry pit, Submersible, Centrifugal
Drive	variable frequency drive
Horsepower.	15
Speed-max, rpm	1,140
Capacity per Pump, mgd	1.0

TABLE 1-3. Continued

Design Data	
Denitrification Cells	
Number of Cells	5
Type	Upflow, suspended media
Unit Surface Area, ft ²	151
Number of tanks in service	4
Total Surface Area in Service, ft ²	604
Mudwell Pumps	
Number of Pumps	3
Type	Submersible, centrifugal
Drive	Close coupled
Unit Capacity, gpm @ 25 ft. TDH	150.
Effluent Channel/Clear Well	
Number of Channels	1
Average Water Depth, ft	4
Available for Backwash Water Depth, ft	2.3
Overall Channel Dimensions	
Length, ft	42
Width, ft	15
Unit Volume Available for Backwash	
Cf	3,523
Gal.	26,423
Backwash Volume, per Cycle	
Cf	3,460
Gal.	26,000
Mud Well	
Number of Tanks	1
Effective Water Depth, ft	9
Overall Tank Dimensions	
Length, ft	29
Width, ft	31
Unit Volume	
Cf	8091
Gal.	60,682
Backwash Blowers	
Number of Units	2
Type	Rotary, positive displacement
Capacity	100 SCFM
Drive	Adjustable V-belt
Horsepower	10
Pressure (PSIG)	10

TABLE 1-3. Continued

		Design Data
Air Compressor		
Number of Units		1 (Duplex)
Type		Screw
Drive		Adjustable V-belt
Capacity		10 SCFM
Horsepower		3 each
Pressure (PSIG)		125
Denitrification Chemical Systems		
Methanol Storage Tanks		
Number of Tanks		2
Unit Volume, gal.		6,000
Methanol Pumps		
Number of Pumps		3
Type		Diaphragm
Drive		Direct
Unit Capacity, gph @ psi		18 @ 50
Foam Spray Water Pump		
Number of Pumps		1
Type		Submersible, centrifugal
Drive		Close coupled
Capacity, gpm @ 30 ft. TDH		200
CHEMICAL PHOSPHORUS REMOVAL (Second Dosing Point)		
Coagulant Flash Mix Tank		
Number of Trains		1
Flash Mix Tank Dimensions		
Length, ft		6
Width, ft		6
Sidewater depth, feet		9
Volume Total, gal.		2,400
Mixer,		
Type		Top mounted
HP		10

TABLE 1-3. Continued

Design Data	
Aluminum Sulfate (Alum) Storage	
Number of Tanks	2
Unit Capacity, gallons	2,660
Aluminum Sulfate (Alum) Feed Pumps	
Dosing Location	Coagulant Flash Mix Tank
Number of Pumps	2
Type: Pump	Peristaltic
Drive	Direct Variable Speed
Unit Capacity, gph @ 125 psi	33.3
Coagulation and Flocculation Tanks	
Number of Trains	2
Coagulation Tank Dimensions	
Length, ft	13.33
Width, ft	10
Sidewater depth, feet	10.5
Volume Each, gal.	10,500
Volume Total, gal.	21,000
Mixer, per tank	
Type	Top mounted
HP	5
Mixer, HP	
Flocculation Tank Dimensions	
Length, ft	12.5
Width, ft	10
Sidewater depth, feet	10.5
Volume Each, gal.	10,000
Volume Total, gal.	20,000
Mixer, per tank	
Type	Top mounted
HP	2
Disc Filter Polymer Storage and Feed System	
Dosing Location	Flocculation Tank
Type	Automatic in-line with dry preparation
Number of dry preparation units	1
Number of metering pumps	3 (one for each flocculation tank one standby)
Type: pump	Hose pump
drive	variable speed gear
Capacity, gph neat polymer	97

TABLE 1-3. Continued

	Design Data
Liquid polymer storage	55 gallon drums
Number of transfer pumps	1
Type: pump drive	Horizontal progressive cavity constant speed gear
Unit capacity, gph	20
Disc Filters	
Number of Filters	3
Number Operating	2
Max. flow/filter; MGD	5.5
Avg. Flow/filter; MGD	2.0
Media Size; microns	10
DISINFECTOIN/REAERATION	
UV Disinfection	
Number of channels	2
Banks/channel	2
Design avg. flow, MGD	4.0
Peak design flow, MGD	11.0
Design dose, mJ/cm ²	30
Disinfection Limit/Coliform/100ml	400
Rearation Tanks	
Number of Tanks	2
Volume on Line, gal	21,000
Summer Conditions	
Max Month	
Air Required for Tanks, scfm	916
Peak Conditions	
Air Required for Tanks, scfm	1,975
Winter Conditions	
Max Month	
Air Required for Tanks, scfm	365
Peak Conditions	
Air Required for Tanks, scfm	786

TABLE 1-3. Continued

		Design Data
EFFLUENT AND STORMWATER PUMP STATION		
Effluent Pumps		
Number of pumps		4
Type: Pump		Submersible, Solids Handling
Drive		Variable Frequency
Capacity, gpm @ 20 ft TDH		2,550
Total capacity, 3 pumps, gpm		7,650
Stormwater Pumps		
Number of pumps		2
Type: Pump		Submersible, Solids Handling
Drive		Constant Speed
Capacity, gpm @ 15 ft TDH		335
Total capacity, 2 pumps, gpm		670
SOLIDS HANDLING		
WAS Thickening		
WAS Sludge Equalization Tank		
Volume, gallons		2,300
Mixer,		
Type		Top mounted
HP		1.5
WAS Transfer Pumps		
Number of pumps		2
Number of pumps in service		1
Type: Pump		Rotary Lobe
Drive		Variable Frequency
Capacity, gpm @ 70 ft TDH		65
Rotary Drum Thickener (RDT)		
Number of units		2
Number in service		1
Unit Capacity		
Solids Loading, lbs/hr		440
Volume, gpm		80

TABLE 1-3. Continued

	Design Data
RDT Polymer Storage and Feed System	
Type	Automatic in-line with dry preparation
Number of dry preparation units	1
Number of metering pumps	2
Type: pump drive	Hose pump variable speed gear
Capacity, gph neat polymer	80
Liquid polymer storage	(see belt filter press polymer system)
Thickened WAS Transfer Pumps	
Number of pumps	2
Number of pumps in service	1
Type: Pump Drive	Progressive Cavity Variable Frequency
Capacity, gpm @ 70 ft TDH	5
Gravity Thickening	
Gravity Thickener	
Number of Units	1
Diameter, feet	40
Unit area ft ²	1,258
Depth, feet	10
Unit volume, ft ³	12,576
Total volume, gal	99,993
Solids loading rate, lbs./ft ² /day with DN Filter and Disc Filter Recycles	0.7
Gravity Thickened Dilution Water Pumps	
Number of pumps	2
Number of pumps in service	1
Type: Pump Drive	Horizontal Centrifugal Variable Frequency
Capacity, gpm @ 20 ft TDH	330
Gravity Thickened Sludge Pumps	
Number of pumps	2
Number of pumps in service	1
Type: Pump Drive	Simplex Plunger Constant Speed
No of pin positions	5
Capacity, gpm @ 240 ft TDH	60

TABLE 1-3. Continued

		Design Data
Anaerobic Digestion		
Anaerobic Digesters		
Number of units		
Primary		1
Secondary		1
Type of cover		
Primary tank		Fixed dome
Secondary		Floating gas holder
Diameter, feet		
Primary		45
Secondary		45
Side water depth, feet		
Primary		30.5
Secondary		27.5
Total volume, ft ³		
Primary		48,545
Secondary		43,770
Sludge volume applied, gpd (ave)		29,500
Detention time, days		
Primary		12.3
Secondary		11.1
Type of mixing		Pumped (see below)
Digester Sludge Mixing Pumps		
Number of pumps		2
Number of pumps in service		1
Type: Pump		Horizontal End Suction Chopper
Drive		Variable Frequency
Capacity, gpm @ 33 ft TDH		1,700
Digester Sludge Recirculation (Heating) Pumps		
Number of pumps		2
Number of pumps in service		1
Type: Pump		Recessed Impeller
Drive		Constant Speed
Capacity, gpm @ 25 ft TDH		150
Sludge Recirculation (heating) Pump Grinder		
Number of units		1
Number in service		1
Unit motor size, hp		3

TABLE 1-3. Continued

Design Data	
Belt Filter Press (BFP)	
Belt Filter Press Feed Sludge Grinder	
Number of units	1
Number in service	1
Unit motor size, hp	3
Belt Filter Press Feed Pumps	
Number of pumps	2
Number of pumps in service	1
Type: Pump	Progressive Cavity
Drive	Variable Frequency
Capacity, gpm @ 140 ft TDH	200
BFP Polymer Storage and Feed System	
Type	Automatic in-line with dry preparation
Number of dry preparation units	2
Number of metering pumps	2
Type: pump drive	Hose pump variable speed gear
Capacity, gph neat polymer	353
Liquid polymer storage	55 gallon drums
Number of transfer pumps	2
Type: pump drive	Horizontal progressive cavity constant speed gear
Unit capacity, gph	40
Belt Filter Presses	
Number of units	2
Unit width, meters	2
Sludge dry solids applied	
Average, lbs/week	40,660
Max month, lbs/week	51,550
Unit solids loading rate, lb/m/hr	600
Units in operations	1
Operating hours	
Average day	6.8
Maximum day	8.6
Belt Filter Washwater Pumps	
Number of pumps	2
Number of pumps in service	1
Type: Pump	Horizontal Centrifugal
Drive	Direct

TABLE 1-3. Continued

	Design Data
Capacity, gpm @ 90 ft TDH	90
Washwater Booster Pumps	
Number of pumps	2
Number of pumps in service	1
Type: Pump	Vertical Inline Centrifugal
Drive	Direct
Capacity, gpm @ 105 ft TDH	90
Effluent Flushing Water Pumps	
Number of pumps	3
Number of pumps in service	1
Type: Pump	Horizontal Centrifugal
Drive	Variable Frequency
Capacity, gpm @ 160 ft TDH	260
Foam Spray Water Pumps	
Number of pumps	3
Number of pumps in service	1
Type: Pump	Horizontal Centrifugal
Drive	Direct
Capacity, gpm @ 42 ft TDH	300